

DATE: October 15, 2025

DEPARTMENT OF GENERAL SERVICES
BUREAU OF CAPITAL PROJECT DESIGN MANAGEMENT
1800 HERR STREET
HARRISBURG, PENNSYLVANIA

ADDENDUM NO. 6

on

PROJECT NO. DGS C-0948-0087 PHASE 001

PROJECT TITLE - PA State Museum - Paver Repair/Replacement

PROFESSIONAL:

Chris Dawson Architect LLC
210 North 3rd Street, Suite C
Harrisburg, PA, 17101

If you submitted a bid prior to this Addendum being issued, your bid has been discarded and you must re-submit your bid(s) prior to the bid opening date and time.

ADMINISTRATIVE CHANGES – ALL CONTRACTS

Item 1 – **CLARIFICATION:** Pre-Bid Conference Sign-In sheet is available online to all on PA DGS website (<https://www.pa.gov/agencies/dgs/submit-proposals-and-bids-for-commonwealth-projects>).

Item 2 – **CLARIFICATION:** The storage area at Fort Indiantown Gap is utilized by PHMC and will be prepared for the arrival of the salvaged materials. The .1 contractor shall coordinate delivery with the Bureau of Construction and PHMC (Lou McCrory). Contractor shall provide suitable on-grade blocking when placing salvaged materials.

Item 3 – **CLARIFICATION:** A site visit to Fort Indiantown Gap is not necessary prior to the proposal deadline.

SPECIFICATION CHANGES – ALL CONTRACTS

Item 1 – **CLARIFICATION:** Specification section 05 53 13 is referenced, in Specification section 01 03 00, 1.3, A, 2, c and Sheets A109, A112.

Item 2 – Specification Section 22 14 13 **ADD:** 3.9 "Piping Schedule" along with subsequent points A, B, and C.

Item 3 – **CLARIFICATION:** unless called out in the drawings or specifications, all existing stone pavers, concrete pavers, and limestone that is not being salvaged for reuse can be disposed of.

Item 4 – **CLARIFICATION:** Per specification section 03 30 00 Section 2.6.A, the contractor is to submit design concrete mixtures for each class of concrete.

DRAWING CHANGES – ALL CONTRACTS

Item 1 – Sheet C-502 & C-701 **CLARIFICATION:** Per Addenda 3 Drawing Change Item 23, P-405 and P-409 was revised to show division of labor between .1 (General) and .3 (Plumbing) Contractors.

Item 2 – Sheet A115 & Addendum 4 Drawing Change Item 19 **CLARIFICATION:** Typical flooring is sealed concrete, existing conditions to be verified in field, and replaced concrete is to match existing.

Item 3 – **CLARIFICATION:** .3 (Plumbing) Contractor work is clearly shown on each base bid plan. Base bids 2 and 3 build on base bid 1. Work on the base bid 2 and 3 drawings includes the previous base bid work for clarity of bidding.

Item 4 – Sheet P425 - P428 **CLARIFICATION:** Some of the plaza drains will need to be excavated, and some are accessible from below. A site visit is recommended to confirm all scope.

Item 5 – Sheet P427 **CLARIFICATION:** The four pipe connections required for the trench drain slightly North of column line AY are shown on Drawing P-415. They are in the lower left corner of the drawing at the closet with the round wall and in the space behind the jagged wall in the auditorium.

Item 6 – Sheet A501, Detail 1A, & 1B **CLARIFICATION:** note reading "SETTING BED. REFER TO SPECS." refers to specification section 32 14 00, 2.5, A.

Item 7 – Sheet A501, Detail 1A, & 1B **CLARIFICATION:** note reading "TOPPING SLAB. REFER TO SPEC." refers to specification section 03 30 00, 1.2, B, 2.

Item 8 – Sheet A501, Detail 10 **REVISE** note "EXISTING GUTTER SYSTEM TO BE PROTECTED DURING CONSTRUCTION. REMOVE ANY CONSTRUCTION DEBRIS FROM GUTTER PRIOR TO INSTALLATION OF EXPANSION JOINT. NO CONSTRUCTION DEBRIS TO BE LEFT IN EXISTING INTERNAL GUTTER SYSTEM" to read "EXISTING GUTTER SYSTEM INSTALLATION TO BE VERIFIED IN FIELD. REMOVE ANY DEBRIS FROM GUTTER PRIOR TO INSTALLATION OF EXPANSION JOINT. NO DEBRIS TO BE LEFT IN EXISTING INTERNAL GUTTER SYSTEM. REINSTALLATION TO MATCH EXISTING"

Item 9 – Sheet S501 Detail 5 & A501 Detail 5 & Addenda 4 Drawing Change Item 65 **CLARIFICATION:** .4 (Electrical) Contractor is responsible for furnishing the site light pole base plates as a part of the site light pole fixtures. .1 (General) Contractor is responsible for installation of the base plate, .4 (Electrical) Contractor is responsible for installation of all other light fixture components.

Item 10 – Sheet S511 Detail 3 **CLARIFICATION:** unsized angle fastening into existing concrete is existing and intended to be reused.

Item 11 – Sheet S511 Detail 3 **CLARIFICATION:** Note reads "NEW L6X4X3/8 STAINLESS STEEL CONTINUOUS ANGLES BETWEEN COLUMNS TO MATCH EXISTING. FINAL CONNECTION DETAIL BETWEEN ANGLES AND TO CONCRETE BEAM TO MATCH EXISTING."

Item 12 – Sheet S501, Detail 3: **CLARIFICATION:** Limestone panels should be set on on stone supports. Stone below to be able to be removed by contractor without impacting the material above. If panels cannot be safely removed, temporary stabilization is required without the destruction or modification of existing panels.

Item 13 – **CLARIFICATION:** Topping slab Thickness can be modified. Per Sheet A501, details 1A & 1B, preferred Thickness is between 3" and 4".

Item 14 – **CLARIFICATION:** Project preference and intent for Horizontal and Vertical Waterproofing is to remove the existing waterproofing down to clean substrate and prep the surfaces for the new

waterproofing installation. Per DGS Project Procedure Manual "No substitutions are considered during bidding. Contractors shall bid the documents as provided. Acceptable or equal substitutions may be considered after bid award."

Item 15 – Sheet CS1 **REVISE** Sheet A314 "S510 FLUE STRUCTURE & GAS METER SCREEN WALL" to read "FLUE STRUCTURE NORTH - DETAIL DRAWINGS".

Item 16 – Sheet CS1 **ADD** Sheet A316 "GAS METER SCREEN WALL - DETAIL DRAWINGS" to Sheet Index.

Item 17 – Sheets LS101, CS3, A101, A103, A104, A105, A106, A111, A201, & A901 **REVISE** Existing Gas Meter & Proposed Screening Elements.

Item 18 – Sheets AD101, AD106, & AD201 **REVISE** to show Existing Gas Meter.

Item 19 – Sheet A314 **MOVE** details 8, 9, 10, 11 to Sheet A316.

Item 20 – Sheet A316, Details 1, 2, 3, & 4 **REVISE** Elements to screen Existing Gas Meter from DGS Project C-0948-0094.

Item 21 – Sheet S509, Detail 3 **REVISE** Dimension string '4' - 6" to read '5' – 7 VIF".

Item 22 – Sheet S509, Detail 3 **REVISE** Drawing note 1. "SEE DETAIL 11/A314 FOR ADDITIONAL INFORMATION ON ASSEMBLY." to read "SEE DETAIL 2/A316 FOR ADDITIONAL INFORMATION ON ASSEMBLY."

Item 23 – Sheets C-103, C-104, C-105, & C-701 **REVISE** Existing Gas Meter & Proposed Screening Elements.

Item 24 – Sheet C-105 **REVISE** Plantings in Southeast planter to account for revise gas meter & screening wall.

Item 25 – Sheet A502 Detail 6 **CLARIFICATION**: Plaza Tent Anchor Basis of Design: Anchor Manufacturing, BL5000 (Modified)

SECTION 221413 - FACILITY STORM DRAINAGE PIPING

PART 1 - GENERAL

1.1 STIPULATIONS

- A. The specifications sections "General Conditions to the Construction Contract", "Special Conditions", and "Division 01 – General Requirements" form a part of this Section by this reference hereto, and shall have the same force and effect as if printed herewith in full.

1.2 SUMMARY

- A. Section Includes:

1. Pipe, tube, and fittings.
2. Specialty pipe fittings.

- B. Related Sections:

1. Section 221429 "Sump Pumps" for storm drainage pumps.
2. Section 334200 "Storm Utility Drainage Piping" for storm drainage piping outside the building.

1.3 PERFORMANCE REQUIREMENTS

- A. Components and installation shall be capable of withstanding the following minimum working pressure unless otherwise indicated:

1. Storm Drainage Piping: 10-foot head of water.

1.4 ACTION SUBMITTALS

- A. Product Data: For each type of product indicated.

1.5 QUALITY ASSURANCE

- A. Piping materials shall bear label, stamp, or other markings of specified testing agency.
- B. Comply with NSF/ANSI 14, "Plastics Piping System Components and Related Materials," for plastic piping components. Include marking with "NSF-drain" for plastic drain piping and "NSF-sewer" for plastic sewer piping.

PART 2 - PRODUCTS

2.1 PIPING MATERIALS

- A. Comply with requirements in "Piping Schedule" Article for applications of pipe, tube, fitting materials, and joining methods for specific services, service locations, and pipe sizes.

2.2 HUB-AND-SPIGOT, CAST-IRON SOIL PIPE AND FITTINGS

- A. Pipe and Fittings: ASTM A 74, **Service** classes.
- B. Gaskets: ASTM C 564, rubber.
- C. Calking Materials: ASTM B 29, pure lead and oakum or hemp fiber.

2.3 HUBLESS, CAST-IRON SOIL PIPE AND FITTINGS

- A. Pipe and Fittings: ASTM A 888 or CISPI 301.
- B. CISPI, Hubless-Piping Couplings:
 1. Manufacturers: Subject to compliance with requirements, **provide products by one of the following:**
 - a. ANACO-Husky.
 - b. Dallas Specialty & Mfg. Co.
 - c. Fernco Inc.
 - d. Matco-Norca, Inc.
 - e. MIFAB, Inc.
 - f. Mission Rubber Company; a division of MCP Industries, Inc.
 - g. Stant.
 - h. Tyler Pipe.
 2. Standards: ASTM C 1277 and CISPI 310.
 3. Description: Stainless-steel corrugated shield with stainless-steel bands and tightening devices; and ASTM C 564, rubber sleeve with integral, center pipe stop.
- C. Cast-Iron, Hubless-Piping Couplings:
 1. Standard: ASTM C 1277.
 2. Description: Two-piece ASTM A 48/A 48M, cast-iron housing; stainless-steel bolts and nuts; and ASTM C 564, rubber sleeve with integral, center pipe stop.

2.4 PVC PIPE AND FITTINGS

- A. Solid-Wall PVC Pipe: ASTM D 2665, drain, waste, and vent.

- B. PVC Socket Fittings: ASTM D 2665, made to ASTM D 3311, drain, waste, and vent patterns and to fit Schedule 40 pipe.
- C. Adhesive Primer: ASTM F 656.
 - 1. Adhesive primer shall have a VOC content of 550 g/L or less when calculated according to 40 CFR 59, Subpart D (EPA Method 24).
 - 2. Adhesive primer shall comply with the testing and product requirements of the California Department of Health Services' "Standard Practice for the Testing of Volatile Organic Emissions from Various Sources Using Small-Scale Environmental Chambers."
- D. Solvent Cement: ASTM D 2564.
 - 1. PVC solvent cement shall have a VOC content of 510 g/L or less when calculated according to 40 CFR 59, Subpart D (EPA Method 24).
 - 2. Solvent cement shall comply with the testing and product requirements of the California Department of Health Services' "Standard Practice for the Testing of Volatile Organic Emissions from Various Sources Using Small-Scale Environmental Chambers."

PART 3 - EXECUTION

3.1 EARTH MOVING

- A. Comply with requirements for excavating, trenching, and backfilling specified in Section 312000 "Earth Moving."

3.2 PIPING INSTALLATION

- A. Drawing plans, schematics, and diagrams indicate general location and arrangement of piping systems. Indicated locations and arrangements were used to size pipe and calculate friction loss, expansion, pump sizing, and other design considerations. Install piping as indicated unless deviations from layout are approved on coordination drawings.
- B. Install piping in concealed locations unless otherwise indicated and except in equipment rooms and service areas.
- C. Install piping indicated to be exposed and piping in equipment rooms and service areas at right angles or parallel to building walls. Diagonal runs are prohibited unless specifically indicated otherwise.
- D. Install piping above accessible ceilings to allow sufficient space for ceiling panel removal.
- E. Install piping to permit valve servicing.
- F. Install piping at indicated slopes.
- G. Install piping free of sags and bends.
- H. Install fittings for changes in direction and branch connections.

- I. Install piping to allow application of insulation.
- J. Make changes in direction for storm drainage piping using appropriate branches, bends, and long-sweep bends. Do not change direction of flow more than 90 degrees. Use proper size of standard increasers and reducers if pipes of different sizes are connected. Reducing size of drainage piping in direction of flow is prohibited.
- K. Lay buried building storm drainage piping beginning at low point of each system. Install true to grades and alignment indicated, with unbroken continuity of invert. Place hub ends of piping upstream. Install required gaskets according to manufacturer's written instructions for use of lubricants, cements, and other installation requirements. Maintain swab in piping and pull past each joint as completed.
- L. Install storm drainage piping at the following minimum slopes unless otherwise indicated:
 - 1. Horizontal Storm-Drainage Piping: 2 percent downward in direction of flow.
- M. Install cast-iron soil piping according to CISPI's "Cast Iron Soil Pipe and Fittings Handbook," Chapter IV, "Installation of Cast Iron Soil Pipe and Fittings."
 - 1. Install encasement on underground piping according to ASTM A 674 or AWWA C105.
- N. Install steel piping according to applicable plumbing code.
- O. Install aboveground copper tubing according to CDA's "Copper Tube Handbook."
- P. Install aboveground ABS piping according to ASTM D 2661.
- Q. Install aboveground PVC piping according to ASTM D 2665.
- R. Plumbing Specialties:
 - 1. Install backwater valves in storm drainage gravity-flow piping. Comply with requirements for backwater valves specified in Section 221423 "Storm Drainage Piping Specialties."
 - 2. Install cleanouts at grade and extend to where building storm drains connect to building storm sewers in storm drainage gravity-flow piping. Install cleanout fitting with closure plug inside the building in storm drainage force-main piping. Comply with requirements for cleanouts specified in Section 221423 "Storm Drainage Piping Specialties."
 - 3. Install drains in storm drainage gravity-flow piping. Comply with requirements for drains specified in Section 221423 "Storm Drainage Piping Specialties."
- S. Do not enclose, cover, or put piping into operation until it is inspected and approved by authorities having jurisdiction.
- T. Install sleeves for piping penetrations of walls, ceilings, and floors. Comply with requirements for sleeves specified in Section 220517 "Sleeves and Sleeve Seals for Plumbing Piping."
- U. Install sleeve seals for piping penetrations of concrete walls and slabs. Comply with requirements for sleeve seals specified in Section 220517 "Sleeves and Sleeve Seals for Plumbing Piping."

3.3 JOINT CONSTRUCTION

- A. Hub-and-Spigot, Cast-Iron Soil Piping Gasketed Joints: Join according to CISPI's "Cast Iron Soil Pipe and Fittings Handbook" for compression joints.
- B. Hub-and-Spigot, Cast-Iron Soil Piping Calked Joints: Join according to CISPI's "Cast Iron Soil Pipe and Fittings Handbook" for lead-and-oakum calked joints.
- C. Hubless, Cast-Iron Soil Piping Coupled Joints: Join according to CISPI 310 and CISPI's "Cast Iron Soil Pipe and Fittings Handbook" for hubless-piping coupling joints.
- D. Threaded Joints: Thread pipe with tapered pipe threads according to ASME B1.20.1. Cut threads full and clean using sharp dies. Ream threaded pipe ends to remove burrs and restore full ID. Join pipe fittings and valves as follows:
 - 1. Apply appropriate tape or thread compound to external pipe threads unless dry seal threading is specified.
 - 2. Damaged Threads: Do not use pipe or pipe fittings with threads that are corroded or damaged. Do not use pipe sections that have cracked or open welds.
- E. Join copper tube and fittings with soldered joints according to ASTM B 828 procedure. Use ASTM B 813, water-flushable, lead-free flux and ASTM B 32, lead-free-alloy solder.
- F. Grooved Joints: Cut groove ends of pipe according to AWWA C606. Lubricate and install gasket over ends of pipes or pipe and fittings. Install coupling housing sections, over gasket, with keys seated in piping grooves. Install and tighten housing bolts.
- G. Flanged Joints: Align bolt holes. Select appropriate gasket material, size, type, and thickness. Install gasket concentrically positioned. Use suitable lubricants on bolt threads. Torque bolts in cross pattern.
- H. Plastic, Nonpressure-Piping, Solvent-Cemented Joints: Clean and dry joining surfaces. Join pipe and fittings according to the following:
 - 1. Comply with ASTM F 402 for safe-handling practice of cleaners, primers, and solvent cements.
 - 2. ABS Piping: Join according to ASTM D 2235 and ASTM D 2661 Appendixes.
 - 3. PVC Piping: Join according to ASTM D 2855 and ASTM D 2665 Appendixes.

3.4 HANGER AND SUPPORT INSTALLATION

- A. Comply with requirements for pipe hanger and support devices and installation specified in Section 220529 "Hangers and Supports for Plumbing Piping and Equipment."
- B. Support horizontal piping and tubing within 12 inches of each fitting and coupling.
- C. Support vertical piping and tubing at base and at each floor.
- D. Rod diameter may be reduced one size for double-rod hangers, with 3/8-inch minimum rods.

- E. Install hangers for cast-iron soil piping with the following maximum horizontal spacing and minimum rod diameters:
 - 1. NPS 1-1/2 and NPS 2: 60 inches with 3/8-inch rod.
 - 2. NPS 3: 60 inches with 1/2-inch rod.
 - 3. NPS 4 and NPS 5: 60 inches with 5/8-inch rod.
 - 4. NPS 6 and NPS 8: 60 inches with 3/4-inch rod.
 - 5. NPS 10 and NPS 12: 60 inches with 7/8-inch rod.
 - 6. Spacing for 10-foot pipe lengths may be increased to 10 feet. Spacing for fittings is limited to 60 inches.
- F. Install supports for vertical cast-iron soil piping every 15 feet.
- G. Install hangers for steel piping with the following maximum horizontal spacing and minimum rod diameters:
 - 1. NPS 1-1/4: 84 inches with 3/8-inch rod.
 - 2. NPS 1-1/2: 108 inches with 3/8-inch rod.
 - 3. NPS 2: 10 feet with 3/8-inch rod.
 - 4. NPS 2-1/2: 11 feet with 1/2-inch rod.
 - 5. NPS 3: 12 feet with 1/2-inch rod.
 - 6. NPS 4 and NPS 5: 12 feet with 5/8-inch rod.
 - 7. NPS 6 and NPS 8: 12 feet with 3/4-inch rod.
 - 8. NPS 10 and NPS 12: 12 feet with 7/8-inch rod.
- H. Install supports for vertical steel piping every 15 feet.
- I. Install hangers for PVC piping with the following maximum horizontal spacing and minimum rod diameters:
 - 1. NPS 1-1/2 and NPS 2: 48 inches with 3/8-inch rod.
 - 2. NPS 3: 48 inches with 1/2-inch rod.
 - 3. NPS 4 and NPS 5: 48 inches with 5/8-inch rod.
 - 4. NPS 6 and NPS 8: 48 inches with 3/4-inch rod.
 - 5. NPS 10 and NPS 12: 48 inches with 7/8-inch rod.
- J. Install supports for vertical PVC piping every 48 inches.
- K. Support piping and tubing not listed above according to MSS SP-69 and manufacturer's written instructions.

3.5 CONNECTIONS

- A. Drawings indicate general arrangement of piping, fittings, and specialties.
- B. Connect interior storm drainage piping to exterior storm drainage piping. Use transition fitting to join dissimilar piping materials.
- C. Connect storm drainage piping to roof drains and storm drainage specialties.

1. Install test tees (wall cleanouts) in conductors near floor, and floor cleanouts with cover flush with floor.
- D. Where installing piping adjacent to equipment, allow space for service and maintenance of equipment.
- E. Make connections according to the following unless otherwise indicated:
 1. Install unions, in piping NPS 2 and smaller, adjacent to each valve and at final connection to each piece of equipment.
 2. Install flanges, in piping NPS 2-1/2 and larger, adjacent to flanged valves and at final connection to each piece of equipment.

3.6 IDENTIFICATION

- A. Identify exposed storm drainage piping. Comply with requirements for identification specified in Section 220553 "Identification for Plumbing Piping and Equipment."

3.7 FIELD QUALITY CONTROL

- A. During installation, notify authorities having jurisdiction at least 24 hours before inspection must be made. Perform tests specified below in presence of authorities having jurisdiction.
 1. Roughing-in Inspection: Arrange for inspection of piping before concealing or closing-in after roughing-in.
 2. Final Inspection: Arrange for final inspection by authorities having jurisdiction to observe tests specified below and to ensure compliance with requirements.
- B. Reinspection: If authorities having jurisdiction find that piping will not pass test or inspection, make required corrections and arrange for reinspection.
- C. Reports: Prepare inspection reports and have them signed by authorities having jurisdiction.
- D. Test storm drainage piping according to procedures of authorities having jurisdiction or, in absence of published procedures, as follows:
 1. Test for leaks and defects in new piping and parts of existing piping that have been altered, extended, or repaired. If testing is performed in segments, submit separate report for each test, complete with diagram of portion of piping tested.
 2. Leave uncovered and unconcealed new, altered, extended, or replaced storm drainage piping until it has been tested and approved. Expose work that was covered or concealed before it was tested.
 3. Test Procedure: Test storm drainage piping on completion of roughing-in. Close openings in piping system and fill with water to point of overflow, but not less than 10-foot head of water. From 15 minutes before inspection starts until completion of inspection, water level must not drop. Inspect joints for leaks.
 4. Repair leaks and defects with new materials and retest piping, or portion thereof, until satisfactory results are obtained.
 5. Prepare reports for tests and required corrective action.

3.8 CLEANING

- A. Clean interior of piping. Remove dirt and debris as work progresses.
- B. Protect drains during remainder of construction period to avoid clogging with dirt and debris and to prevent damage from traffic and construction work.
- C. Place plugs in ends of uncompleted piping at end of day and when work stops.

3.9 PIPING SCHEDULE

- A. Flanges and unions may be used on aboveground pressure piping unless otherwise indicated.
- B. Aboveground storm drainage piping shall be the following:
 1. Hubless, cast-iron soil pipe and fittings; CISPI, hubless-piping couplings; and coupled joints.
- C. Underground storm drainage piping shall be any of the following:
 1. Service class, cast-iron soil pipe and fittings; gaskets; and gasketed joints.
 2. Solid-wal PVC pipe, PVC socket fittings, and solvent-cemented joints.
 3. Dissimilar Pipe-Material Couplings: [Unshielded] [Shielded], nonpressure transition couplings.

END OF SECTION 221413

COMMONWEALTH OF PENNSYLVANIA

DEPARTMENT OF GENERAL SERVICES

HARRISBURG, PENNSYLVANIA

JOSH SHAPIRO, GOVERNOR

REGINALD B. McNEIL II, ACTING
SECRETARY OF GENERAL SERVICES

PROJECT NO. D.G.S. 948-87 PHASE 1.0
PLAZA PAVER REPAIR / REPLACEMENT
PA STATE MUSEUM, THE CAPITOL COMPLEX
HARRISBURG, DAUPHIN COUNTY, PENNSYLVANIA

ARCHITECT / DESIGN PROFESSIONAL

CHRIS DAWSON ARCHITECT
210 NORTH THIRD ST, SUITE C
HARRISBURG, PA 17101
PHONE: (717) 805-5090

SITE/CIVIL & LANDSCAPE ARCHITECTURE CONSULTANT

K&W ENGINEERS
2201 NORTH FRONT ST, SUITE 200
HARRISBURG, PA 17110
PHONE: (717) 635-2835

FORENSICS & RESTORATION DESIGN CONSULTANT

WALTER P MOORE
180 MAIDEN LANE
NEW YORK, NY 10038
PHONE: (917) 460-0854

LIGHTING CONSULTANT

BARTON ASSOCIATES
221 W. PHILADELPHIA STREET
YORK, PA 17401
PHONE: (717) 817-2276

SITE SURVEY CONSULTANT



HONOR ENGINEER CO.
1100 NORTH MOUNTAIN RD, SUITE 1
HARRISBURG, PA 17112
PHONE: (717) 571-2229

HISTORIC RESEARCH & PRESERVATION CONSULTANT

HISTORIC PRESERVATION CONSULTING, LLC
MECHANICSBURG, PA 17055
PHONE: (717) 512-1032

SUSTAINABILITY & PLUMBING CONSULTANT

KRUG RESOURCES GROUP
WEST CHESTER, PA 19380
PHONE: (610) 299-3353

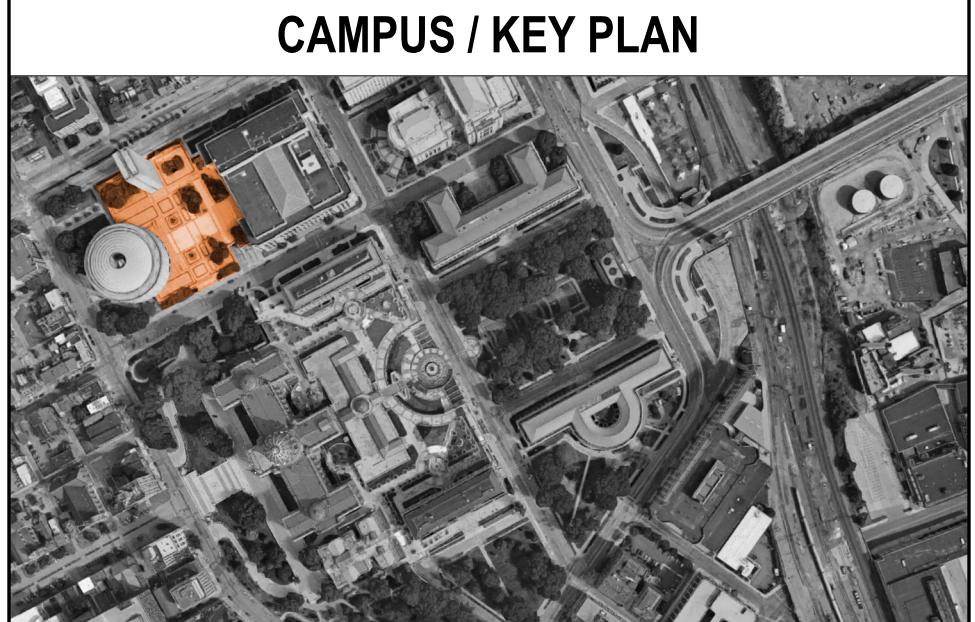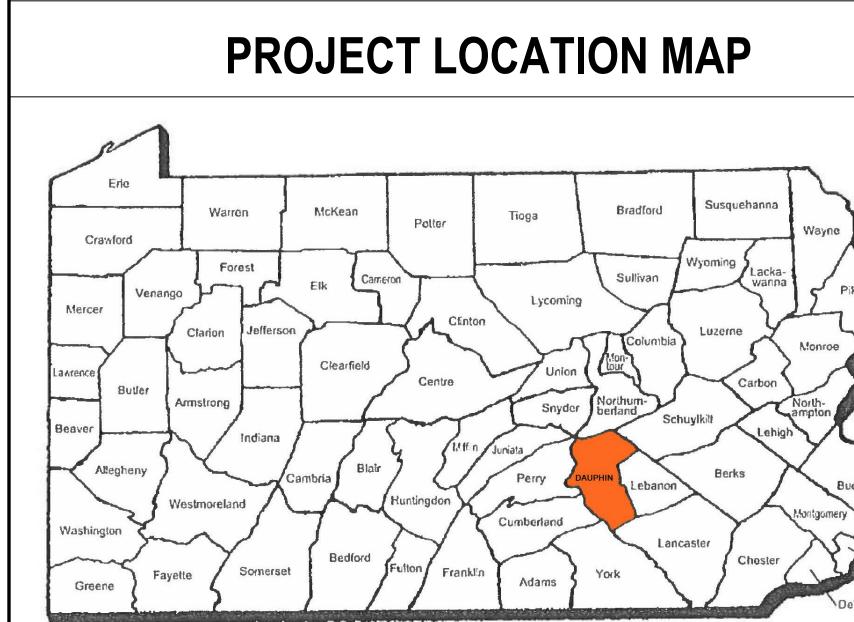

PAVER REPAIR / REPLACEMENT CONTRACT NO. DGS C-0948-0087-PHASE 1.0 SHEET INDEX

DRAWINGS COMMON

TO ALL CONTRACTS

LS102 CODE REVIEW PLAN - GROUND FLOOR
CS1 COVER SHEET
LS101 CODE REVIEW PLAN - PLAZA FLOOR PLAN
CS2 GENERAL NOTES, SYMBOL LEGEND, ABBREVIATIONS
CS4 GROUND FLOOR SEQUENCING PLAN
CS3 PLAZA SEQUENCING PLAN

GENERAL CONSTRUCTION

PROJECT NO. D.G.S 948-87.1

CIVIL DRAWINGS

C-101 EXISTING FEATURES PLAN
C-102 DEMOLITION PLAN
C-103 GRADING PLAN
C-104 UTILITY PLAN
C-105 LANDSCAPE PLAN
C-301 PROFILES
C-501 DETAIL SHEET
C-502 DETAIL SHEET
C-701 EROSION AND SEDIMENTATION CONTROL PLAN
C-702 E&S DETAIL SHEET

DEMOLITION DRAWINGS

AD102 DEMOLITION - PLAZA FLOOR PLAN - ENLARGED AREA A
AD103 EXISTING PLAZA PHOTOGRAPHS - AREA A
AD104 DEMOLITION - PLAZA FLOOR PLAN - ENLARGED AREA B
AD105 EXISTING PLAZA PHOTOGRAPHS - AREA B
AD107 EXISTING PLAZA PHOTOGRAPHS - AREA C
AD108 DEMOLITION - PLAZA FLOOR PLAN - ENLARGED AREA D
AD109 EXISTING PLAZA PHOTOGRAPHS - AREA D
AD110 DEMOLITION - GROUND FLOOR PLAN
AD111 DEMOLITION - GROUND FLOOR RCP
AD112 ASBESTOS ABATEMENT - GROUND FLOOR PLAN
AD202 DEMOLITION - EXTERIOR ELEVATIONS
AD203 DEMOLITION - COURTYARD ELEVATIONS
AD101 DEMOLITION - PLAZA FLOOR PLAN
AD106 DEMOLITION - PLAZA FLOOR PLAN - ENLARGED AREA C
AD201 DEMOLITION - EXTERIOR ELEVATIONS
AD204 PCB ABATEMENT - EXTERIOR ELEVATIONS

ARCHITECTURAL DRAWINGS

A102 STAGING ELEVATIONS & GROUND FLOOR PLAN
A107 PLAZA PAVING PLAN - ENLARGED AREAS
A108 PLAZA PAVING PLAN - ENLARGED AREAS
A109 PLAZA FLOOR PLAN - ENLARGED AREA A
A110 PLAZA FLOOR PLAN - ENLARGED AREA B
A112 PLAZA FLOOR PLAN - ENLARGED AREA D
A113 STONE REUSE PLAN
A114 INSULATION DEPTH PLAN
A115 GROUND FLOOR PLAN
A116 GROUND FLOOR RCP
A202 PLAZA - EXTERIOR ELEVATIONS
A203 COURTYARD - EXTERIOR ELEVATIONS
A301 NORTH STREET STAIR - DETAIL DRAWINGS
A302 FORSTER STREET STAIR - DETAIL DRAWINGS
A303 MUSEUM STAIR - DETAIL DRAWINGS
A304 NORTH STREET RAMP - DETAIL DRAWINGS
A305 NORTH STREET RAMP - DETAIL DRAWINGS
A306 NORTH STREET RAMP - DETAIL DRAWINGS
A307 NORTH STREET RAMP - DETAIL DRAWINGS
A308 SHADE STRUCTURE WEST - DETAIL DRAWINGS
A309 SHADE STRUCTURE WEST - DETAIL DRAWINGS
A310 SHADE STRUCTURE EAST - DETAIL DRAWINGS
A311 PLANTER LAWN SOUTH - DETAIL DRAWINGS
A312 PLANTER LAWN NORTH - DETAIL DRAWINGS
A313 PLANTER WEST - DETAIL DRAWINGS
A315 RAILING DETAILS
A502 PAVER DETAILS CONTINUED
A503 STANDARD PAVER DETAILS
A504 GRADE WATERPROOFING DETAILS
A505 FORSTER STREET & MUSEUM RAMP DETAILS
A506 NORTH STREET RAMP DETAILS
A507 SHADE STRUCTURE DETAILS
A508 STONE SIZE SCHEDULE
A509 STONE SIZE SCHEDULE
A510 SIGN DETAILS
A902 RENDERINGS
A903 RENDERINGS
A904 RENDERINGS
A905 RENDERINGS
A906 RENDERINGS

ARCHITECTURAL DRAWINGS

A907 RENDERINGS
A908 RENDERINGS
A909 RENDERINGS
A910 RENDERINGS - SHADE STRUCTURE SOLAR STUDY
A101 ARCHITECTURAL SITE PLAN
A103 PLAZA FLOOR PLAN
A104 PLAZA PAVING PLAN - BASE BID 1
A105 PLAZA PAVING PLAN - BASE BID 2
A106 PLAZA PAVING PLAN - BASE BID 3
A111 PLAZA FLOOR PLAN - ENLARGED AREA C
A201 PLAZA - EXTERIOR ELEVATIONS
A314 FLUE STRUCTURE NORTH - DETAIL DRAWINGS
A316 GAS METER SCREEN WALL - DETAIL DRAWINGS
A501 PAVER DETAILS
A901 FINISH PLAN & SCHEDULE

STRUCTURAL / WATERPROOFING DRAWINGS

S001 GENERAL NOTES
S002 GENERAL NOTES
DM1.00 DEMOLITION DETAILS
DM2.00 DEMOLITIONS DETAILS
DM3.00 DEMOLITIONS DETAILS
S501 WATERPROOFING DETAILS
S502 WATERPROOFING DETAILS
S503 WATERPROOFING DETAILS
S504 GRADE WATERPROOFING DETAILS
S505 FORESTER STREET & MUSEUM RAMP DETAILS
S506 SNOWMELT WATERPROOFING DETAILS
S507 NORTH STREET RAMP DETAILS
S508 NORTH STREET RAMP DETAILS
S509 SUNSHADE STRUCTURE DETAILS
S510 FLUE STRUCTURE & GAS METER SCREEN WALL
S511 WATERPROOFING DETAILS

HVAC CONSTRUCTION

PROJECT NO. D.G.S 948-87.2
HVAC DRAWINGS

M-001 HVAC GENERAL NOTES AND ABBREVIATIONS
M-101 BASEMENT FLOOR PLAN - HVAC
M-102 PLAZA LEVEL PLAN - HVAC
M-401 HVAC LARGE SCALE

PLUMBING CONSTRUCTION

PROJECT NO. D.G.S 948-87.3

PLUMBING DRAWINGS

P-001 PLUMBING ABBREVIATIONS AND GENERAL INFORMATION
P-101 UNDERSLAB FLOOR PLAN - PLUMBING - BASE BID 001
P-102 UNDERSLAB FLOOR PLAN - PLUMBING - BASE BID 002
P-103 UNDERSLAB FLOOR PLAN - PLUMBING - BASE BID 003
P-104 BASEMENT FLOOR PLAN - PLUMBING - BASE BID 001
P-105 BASEMENT FLOOR PLAN - PLUMBING - BASE BID 002
P-106 BASEMENT FLOOR PLAN - PLUMBING - BASE BID 003
P-107 PLAZA LEVEL PLAN - PLUMBING

STRUCTURAL CONSTRUCTION

PROJECT NO. D.G.S 948-87.4

ELECTRICAL DRAWINGS

P-401 UNDERSLAB LARGE SCALE - AREA A
P-402 UNDERSLAB LARGE SCALE - AREA B
P-403 UNDERSLAB LARGE SCALE - AREA C
P-404 UNDERSLAB LARGE SCALE - AREA D
P-405 UNDERSLAB LARGE SCALE - AREA A
P-406 UNDERSLAB LARGE SCALE - AREA B
P-407 UNDERSLAB LARGE SCALE - AREA C
P-408 UNDERSLAB LARGE SCALE - AREA D
P-409 UNDERSLAB LARGE SCALE - AREA A
P-410 UNDERSLAB LARGE SCALE - AREA B
P-411 UNDERSLAB LARGE SCALE - AREA C
P-412 UNDERSLAB LARGE SCALE - AREA D
P-413 BASEMENT LARGE SCALE - AREA A
P-414 BASEMENT LARGE SCALE - AREA B
P-415 BASEMENT LARGE SCALE - AREA C
P-416 BASEMENT LARGE SCALE - AREA D
P-417 BASEMENT LARGE SCALE - AREA A
P-418 BASEMENT LARGE SCALE - AREA B
P-419 BASEMENT LARGE SCALE - AREA C
P-420 BASEMENT LARGE SCALE - AREA D

PLUMBING CONSTRUCTION

PROJECT NO. D.G.S 948-87.4

PLUMBING SCHEDULES

P-601 PLUMBING SCHEDULES
P-801 UNDERSLAB FLOOR PLAN - PLUMBING DEMO - BASE BID 001
P-802 UNDERSLAB FLOOR PLAN - PLUMBING DEMO - BASE BID 002
P-803 UNDERSLAB FLOOR PLAN - PLUMBING DEMO - BASE BID 003
P-804 BASEMENT FLOOR PLAN - PLUMBING DEMO
P-805 PLAZA LEVEL PLAN - PLUMBING DEMO
P-901 PLUMBING ISOMETRICS

ELECTRICAL CONSTRUCTION

PROJECT NO. D.G.S 948-87.4

ELECTRICAL DRAWINGS

E001 COVER SHEET - ELECTRICAL
E002 SCHEDULES & DETAILS - ELECTRICAL
ED100 GROUND FLOOR PLAN - DEMOLITION - ELECTRICAL
ED101 SITE PLAN - DEMOLITION - ELECTRICAL
E100 GROUND FLOOR PLAN - ELECTRICAL
E101 SITE PLAN - ELECTRICAL

CDA
CHRIS DAWSON ARCHITECT

300 NORTH 2ND STREET, SUITE 701, HARRISBURG, PA 17101

COMMONWEALTH OF PENNSYLVANIA
DEPARTMENT OF GENERAL SERVICES

HARRISBURG, PENNSYLVANIA

D.G.S. PROJECT No. DGS 948-87 PHASE 1

PLAZA PAVER REPAIR / REPLACEMENT
PA STATE MUSEUM,
THE CAPITOL COMPLEX
HARRISBURG, DAUPHIN COUNTY, PA

COVER SHEET

DRAWN BY DS DATE 07.29.25 DRAWING NO.
CHECKED BY WE SCALE PER DWG
CS1

 
DRAWING SET IS INTENDED FOR COLOR PRINTING


CODE APPROVALS

AGENCY / DESCRIPTION

PA DEPARTMENT OF LABOR & INDUSTRY UCC PERMIT DATE 07/30/2024

REGISTERED ARCHITECT
CHRIS DAWSON
PROFESSIONAL'S SIGNATURE



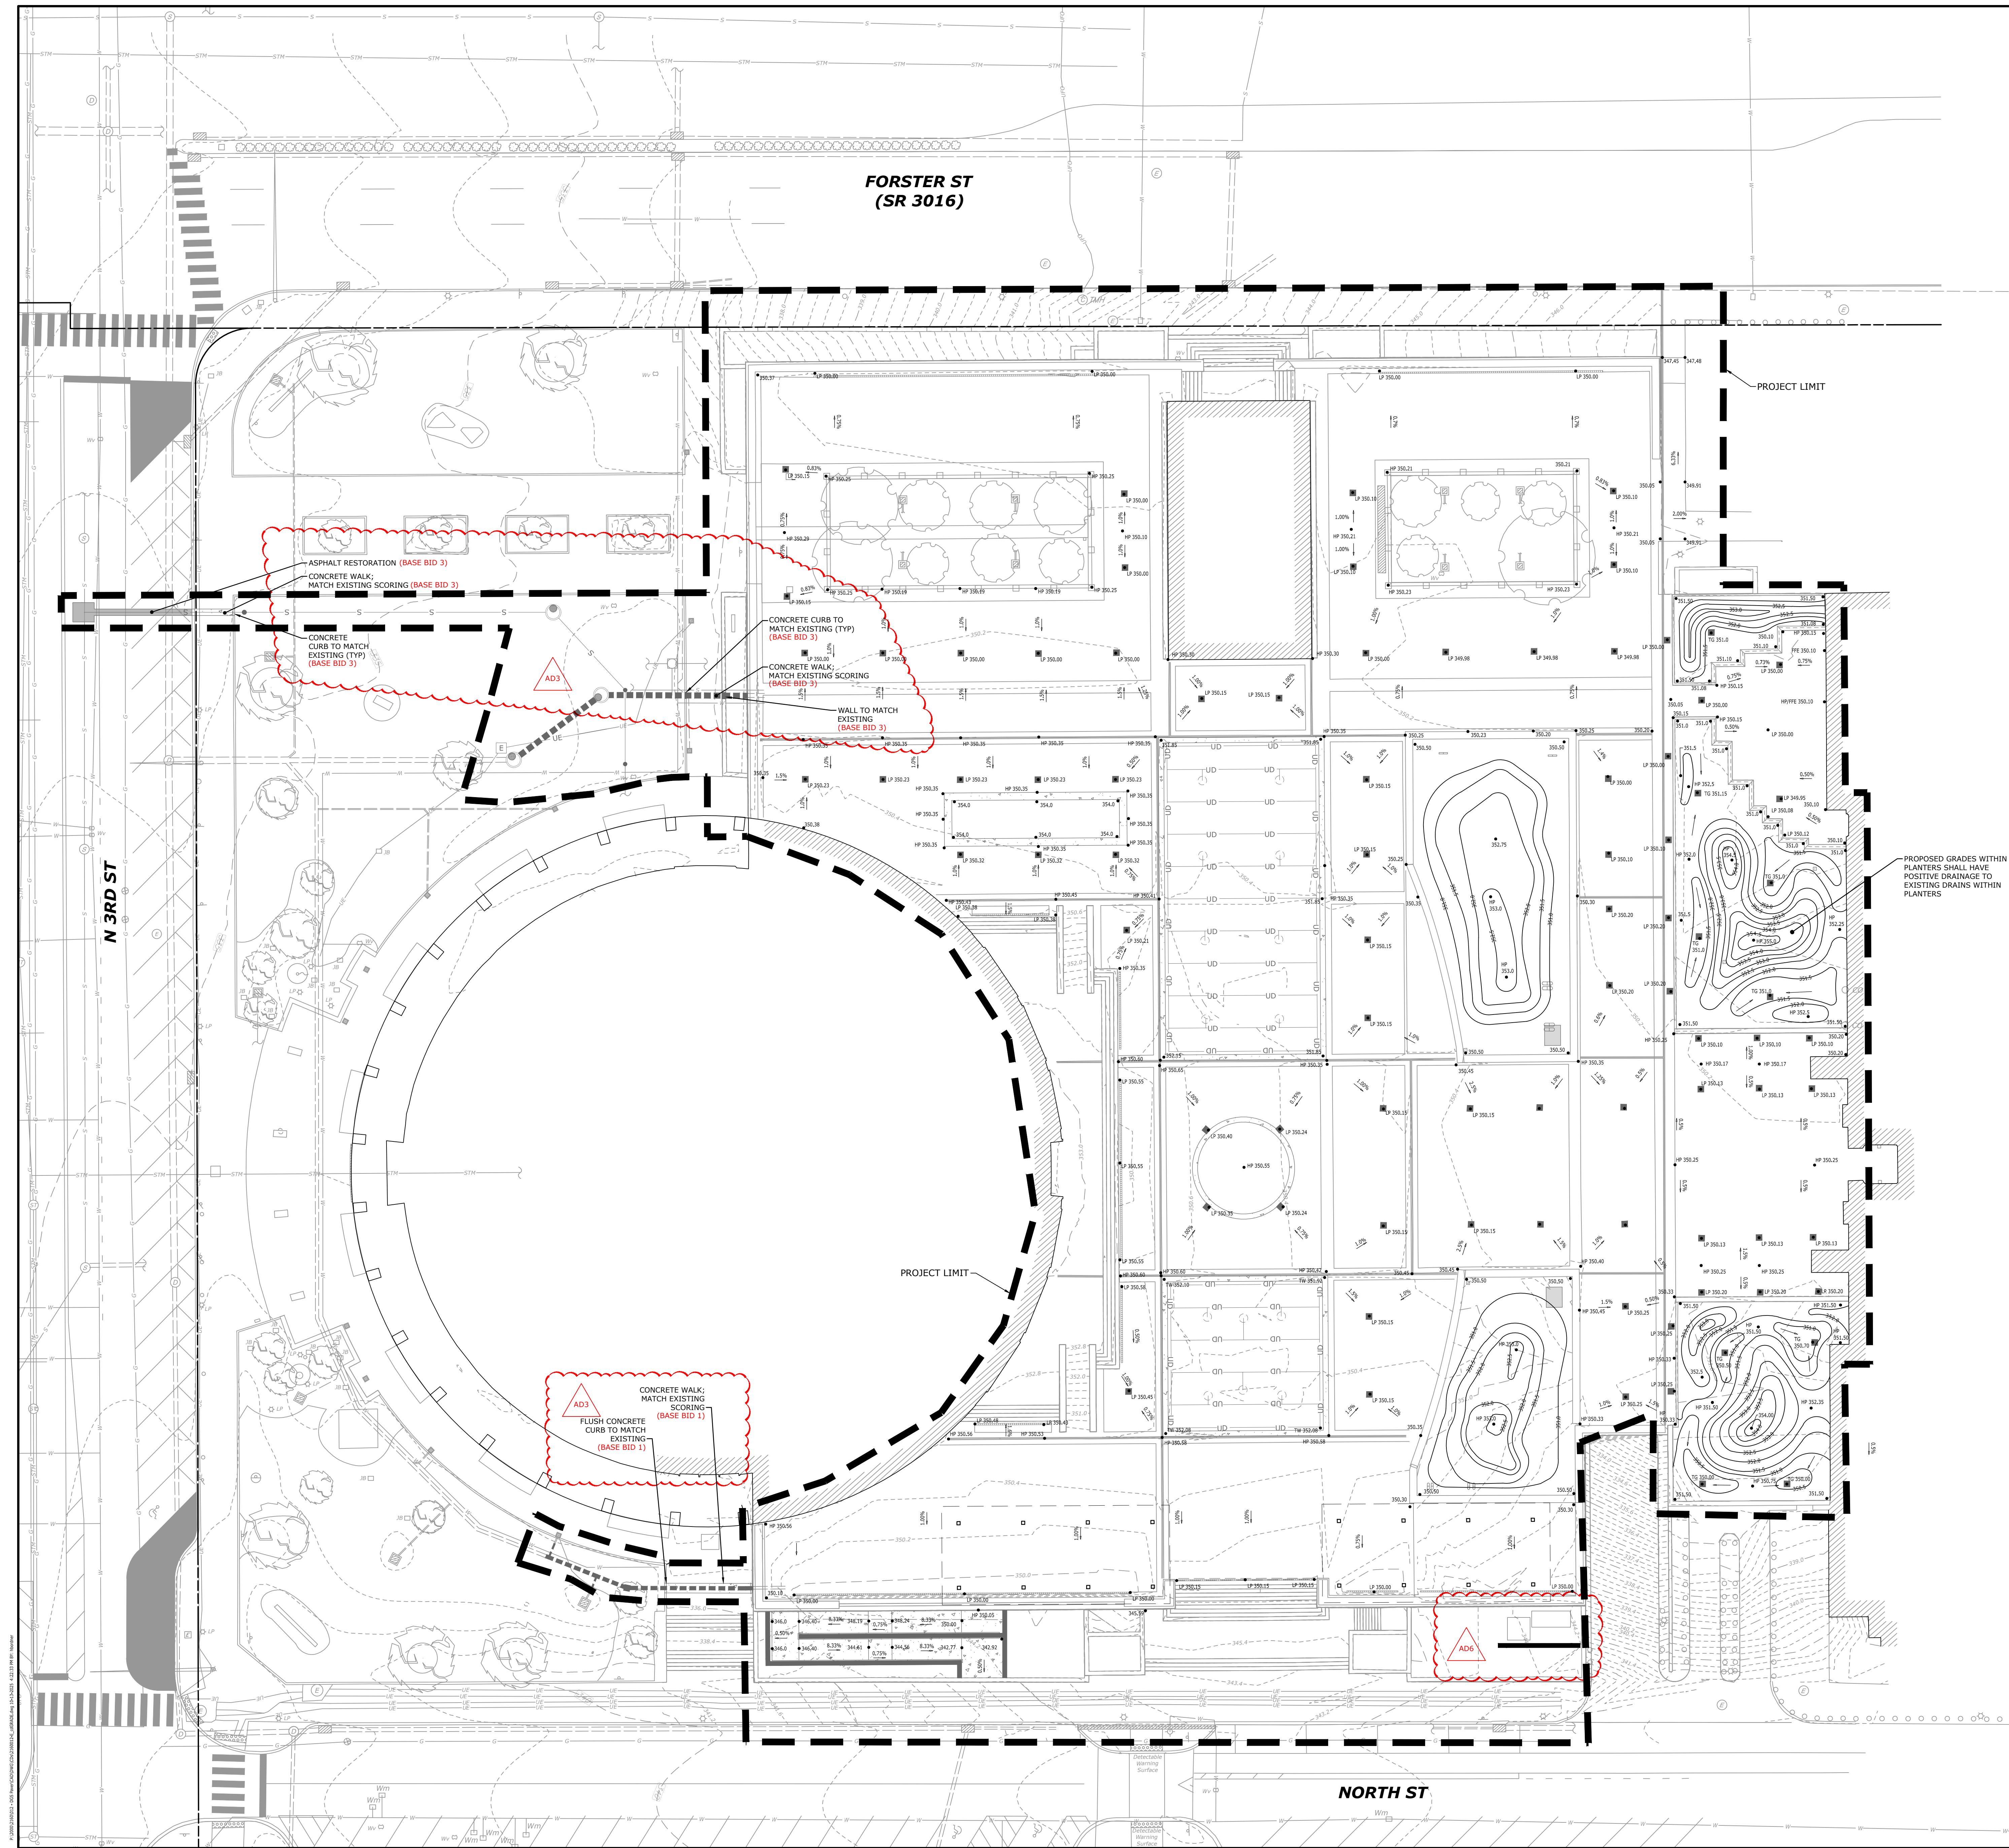

LEGEND


PROPOSED GRADING FEATURES
-421
INTERMEDIATE CONTOUR LINES
-420
INDEX CONTOUR LINES
-422.53
SPOT ELEVATIONS
2.00%
SLOPE OR GRADE LABEL
PROJECT LIMIT

GRADING NOTES

1. REFER TO ARCHITECTURAL DRAWINGS FOR PAVER, PLANTER WALLS/BENCHES, AND SHADE STRUCTURE LAYOUT AND DETAILING.
2. POSITIVE DRAINAGE SHALL BE PROVIDED ACROSS THE ENTIRE PROJECT AREA AND DIRECTED TOWARDS EXISTING AND PROPOSED DRAINS.
3. ALL SOIL SHALL BE REMOVED WITHIN THE PLANTERS ADJACENT TO THE KEYSTONE BUILDING. IN ALL OTHER PLANTERS, THE TOP 3" SHALL BE REMOVED UNLESS FURTHER EXCAVATION IS NEEDED TO CREATE A FEASIBLE PLANTING ENVIRONMENT.

1 Addenda 3 09.15.2025
3 Addenda 6 10.14.2025

AS-BUILT REVISIONS

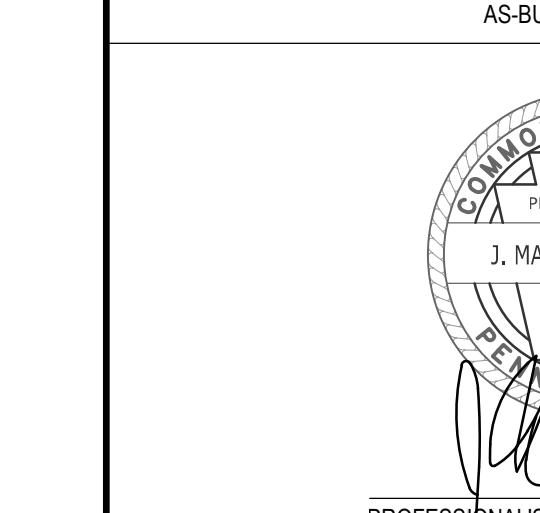

PROFESSIONAL'S SIGNATURE DATE
K&V DESIGNING ENVIRONMENTS
2201 North Front Street, Suite 200
Harrisburg, PA 17110
P: 717.635.2835
www.kandvengineers.com

COMMONWEALTH OF PENNSYLVANIA
DEPARTMENT OF GENERAL SERVICES
HARRISBURG, PENNSYLVANIA
D.G.S. PROJECT No. DGS 948-87 PHASE 1

PLAZA PAVER REPAIR / REPLACEMENT
PA STATE MUSEUM,
THE CAPITOL COMPLEX
HARRISBURG, DAUPHIN COUNTY, PA
GRADING PLAN


DRAWN BY	HAB	DATE	11/08/2024	DRAWING NO.
CHECKED BY	JLL	SCALE	PER DWG	C-103

VERIFY SCALE
BAR IS ONE (1) INCH LONG ON ORIGINAL DRAWING:
0
1
IF BAR IS NOT ONE (1) INCH LONG, ADJUST SCALE ACCORDINGLY

CONTRACTOR SHALL FIELD VERIFY
ALL DIMENSIONS,
VARIES FROM CONTRACT
DOCUMENTS AS PERMITTED
WITHOUT PROFESSIONAL & BUREAU
OF CONSTRUCTION APPROVAL

DRAWN BY
HAB
CHECKED BY
JLL
SCALE
PER DWG

DATE
11/08/2024
DRAWING NO.
C-103

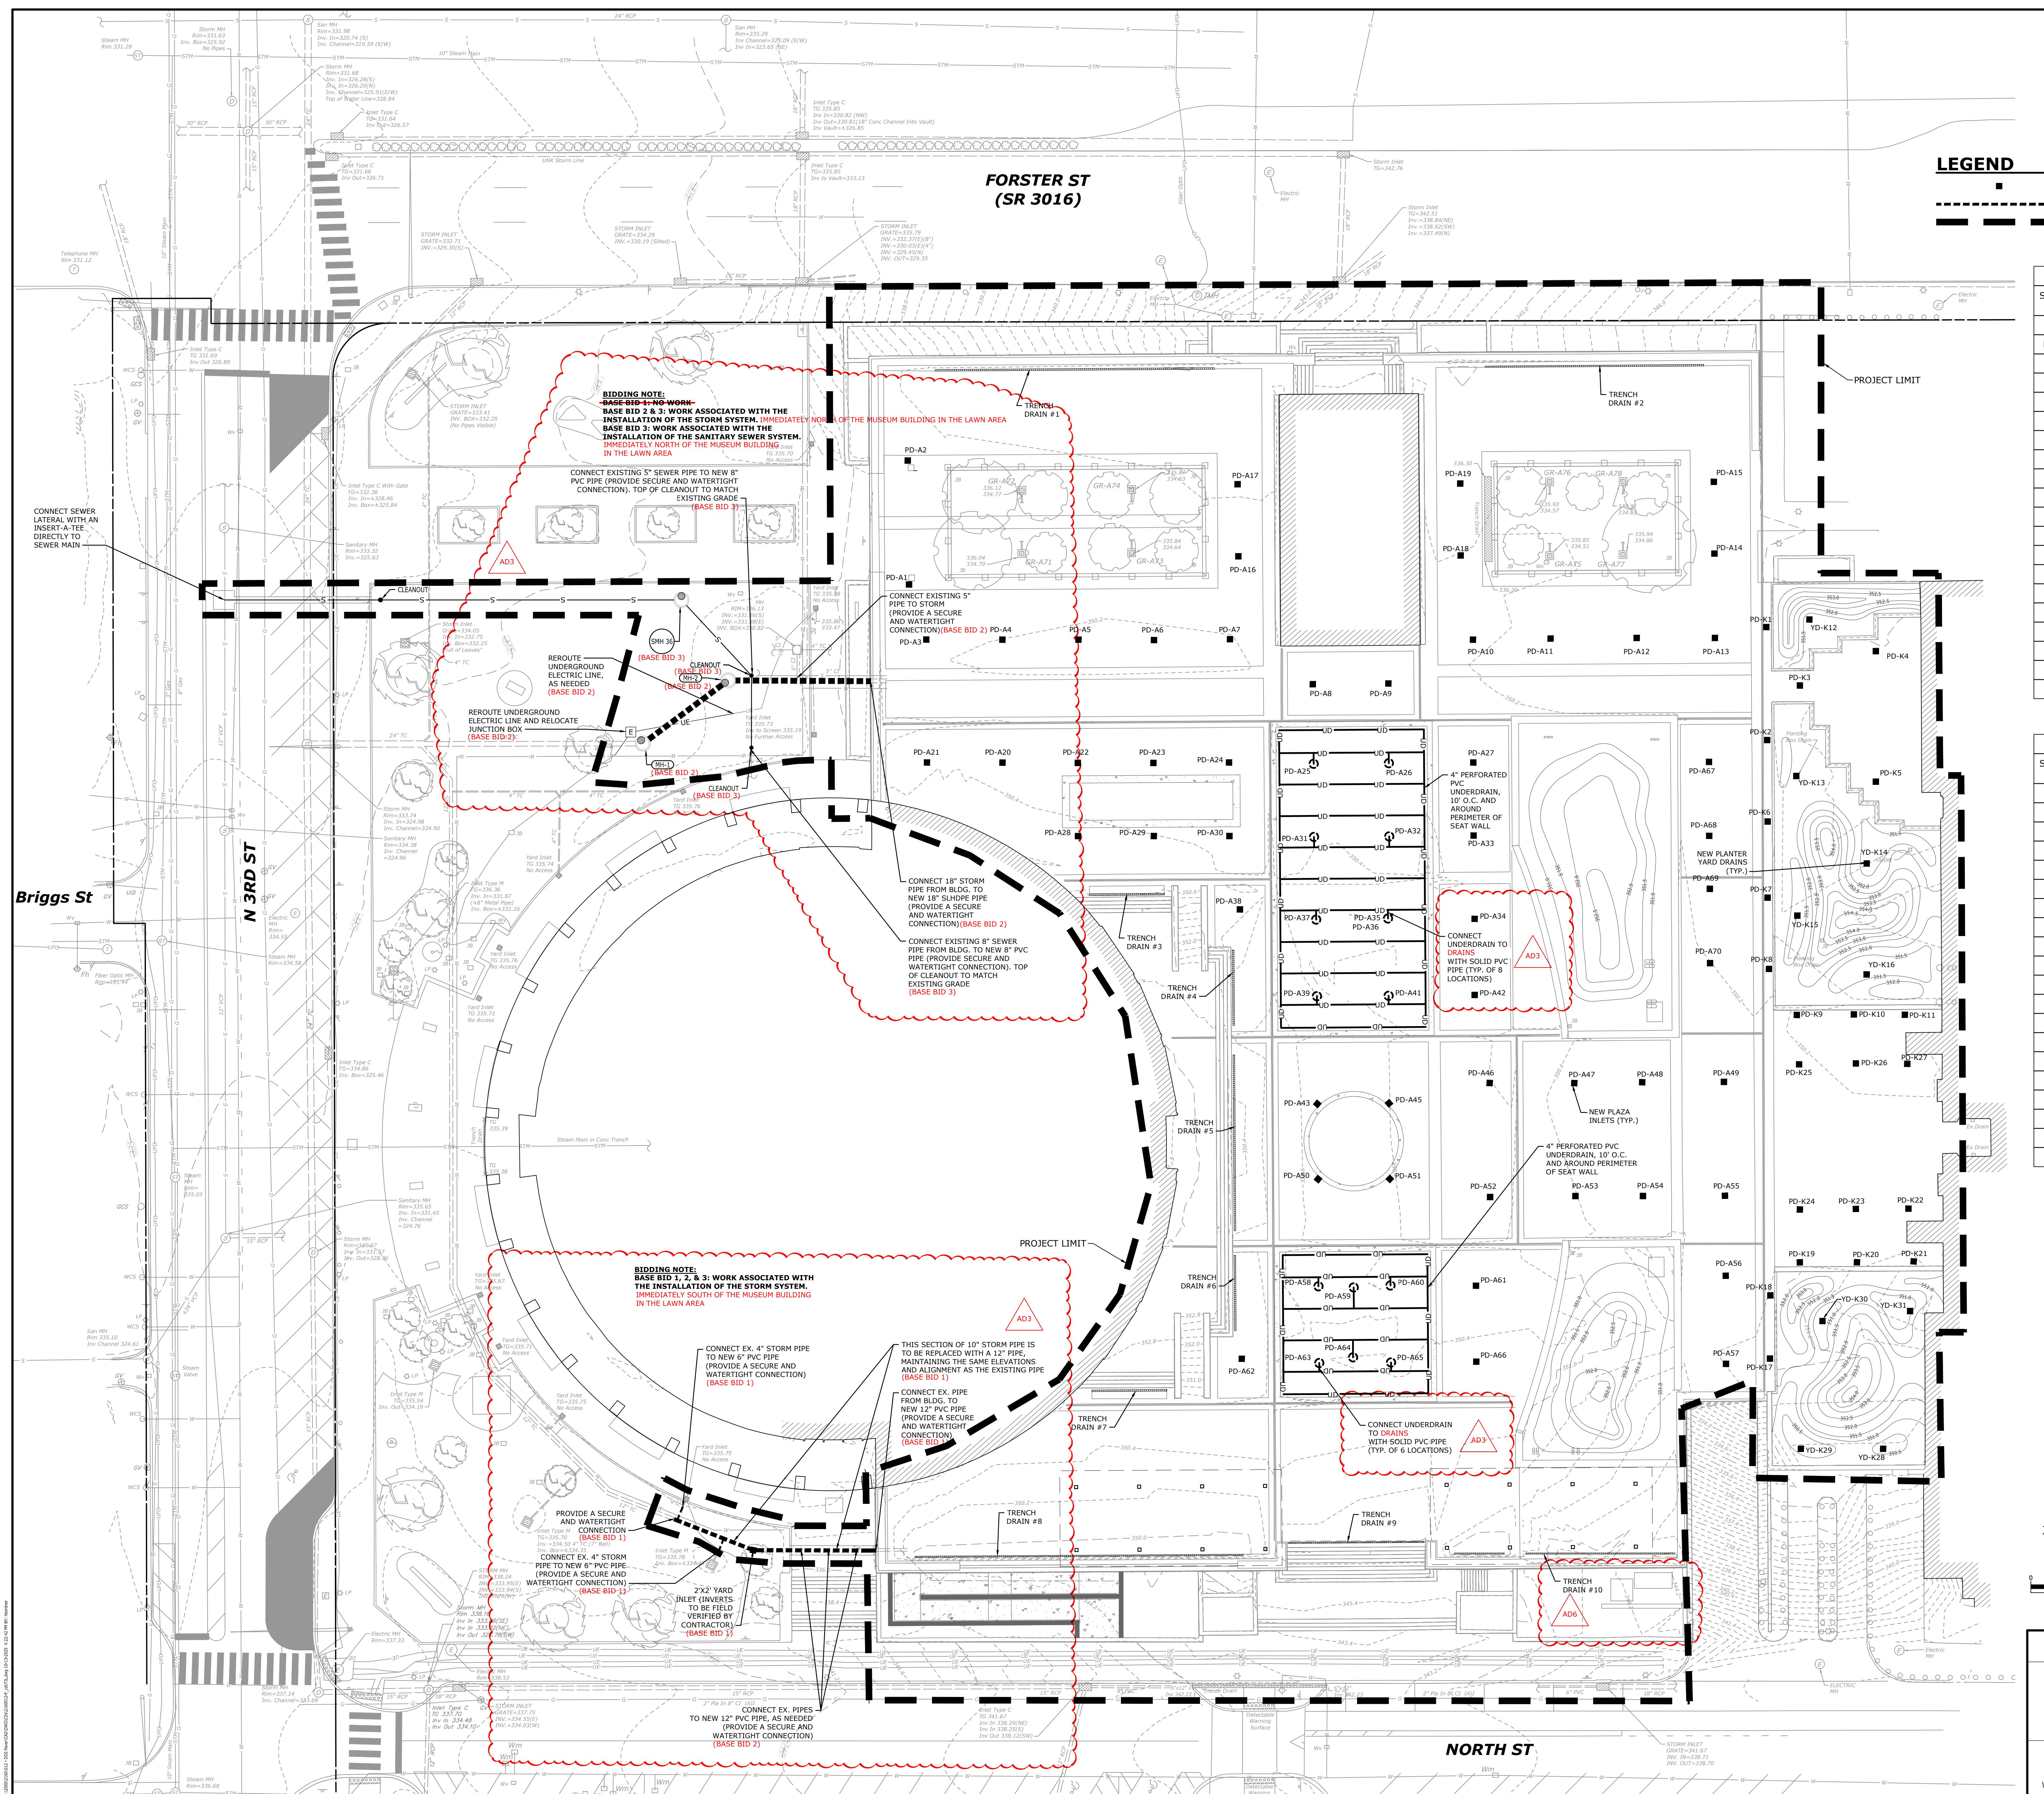

UTILITY NOTES

1. ALL STORMWATER PIPES, CULVERTS, MANHOLES, INLETS, ENDWALLS AND END SECTIONS SHALL BE CONSTRUCTED IN ACCORDANCE WITH THE SPECIFICATIONS SET FORTH IN PENNDOT PUBLICATION 408, AS AMENDED, AND SHALL CONFORM TO THE REQUIREMENTS OF THE PENNDOT, BUREAU OF DESIGN, STANDARDS FOR ROADWAY CONSTRUCTION (RC), PUBLICATION NO. 72, IN EFFECT AT THE TIME THE DESIGN IS SUBMITTED.
2. EXISTING STORMWATER PIPING IS APPROXIMATE AND HAS NOT BEEN SURVEYED OR FIELD VERIFIED.
3. ALL SANITARY SEWER CONSTRUCTION MATERIALS, METHOD AND APPURTENCES SHALL BE IN ACCORDANCE WITH PADEP'S DOMESTIC WASTEWATER FACILITIES MANUAL AND CITY OF HARRISBURG/CRW'S STANDARD SPECIFICATIONS AND DETAILS AT THE TIME OF CONSTRUCTION.
4. ALL SANITARY SEWER LATERAL SECTIONS SHALL BE INSTALLED WITH A MINIMUM SLOPE OF 0.50%.

Structure Table	
Structure Name	Structure Details
MH	TOP = 330.87
SMH	TOP = 331.98
H-1	TOP = 335.88
H-2	TOP = 336.02
-A1	TOP = 350.15
-A2	TOP = 350.15
-A3	TOP = 350.00
-A4	TOP = 350.00
-A5	TOP = 350.00
-A6	TOP = 350.00
-A7	TOP = 350.00
-A8	TOP = 350.15
-A9	TOP = 350.15
-A10	TOP = 350.00
-A11	TOP = 349.98
-A12	TOP = 349.98
-A13	TOP = 349.98
-A14	TOP = 350.10
-A15	TOP = 350.10
-A16	TOP = 350.15

Structure Table	
Structure Name	Structure Details
PD-A17	TOP = 350.1
PD-A18	TOP = 350.1
PD-A19	TOP = 350.1
PD-A20	TOP = 350.1
PD-A21	TOP = 350.1
PD-A22	TOP = 350.1
PD-A23	TOP = 350.1
PD-A24	TOP = 350.1
PD-A25	TOP = 350.3
PD-A26	TOP = 350.3
PD-A27	TOP = 350.1
PD-A28	TOP = 350.1
PD-A29	TOP = 350.1
PD-A30	TOP = 350.1
PD-A31	TOP = 350.3
PD-A32	TOP = 350.3
PD-A33	TOP = 350.1
PD-A34	TOP = 350.1
PD-A35	TOP = 350.2
PD-A37	TOP = 350.3

Structure Table	
Structure Name	Structure Details
PD-A38	TOP = 350.25
PD-A39	TOP = 350.40
PD-A41	TOP = 350.32
PD-A42	TOP = 350.15
PD-A43	TOP = 350.20
PD-A45	TOP = 350.16
PD-A46	TOP = 350.15
PD-A47	TOP = 350.10
PD-A48	TOP = 350.15
PD-A49	TOP = 350.10
PD-A50	TOP = 350.20
PD-A51	TOP = 350.10
PD-A52	TOP = 350.15
PD-A53	TOP = 350.10
PD-A54	TOP = 350.15
PD-A55	TOP = 350.20
PD-A56	TOP = 350.25
PD-A57	TOP = 350.25
PD-A58	TOP = 350.48
PD-A59	TOP = 351.56

Structure Table	
Structure Name	Structure Details
-A60	TOP = 350.28
-A61	TOP = 350.15
-A62	TOP = 350.25
-A63	TOP = 350.42
-A64	TOP = 351.81
-A65	TOP = 350.34
-A66	TOP = 350.15
-A67	TOP = 350.00
-A68	TOP = 350.10
-A69	TOP = 350.20
-A70	TOP = 350.20
-K1	TOP = 350.00
-K2	TOP = 350.00
-K3	TOP = 350.00
-K4	TOP = 350.00
-K5	TOP = 349.95
-K6	TOP = 350.10
-K7	TOP = 350.20
-K8	TOP = 350.20
-K9	TOP = 350.10

Structure Table	
Structure Name	Structure Details
PD-K10	TOP = 350.1
PD-K11	TOP = 350.1
PD-K17	TOP = 350.2
PD-K18	TOP = 350.2
PD-K19	TOP = 350.2
PD-K20	TOP = 350.2
PD-K21	TOP = 350.2
PD-K22	TOP = 350.1
PD-K23	TOP = 350.1
PD-K24	TOP = 350.1
PD-K25	TOP = 350.1
PD-K26	TOP = 350.1
PD-K27	TOP = 350.1
PLAZA	TOP = 330.2
YD-K12	TOP = 350.4
YD-K13	TOP = 350.5
YD-K14	TOP = 350.5
YD-K15	TOP = 350.6
YD-K16	TOP = 350.6
YD-K28	TOP = 350.5

Structure Table	
Structure Name	Structure Details
YD-K29	TOP = 350.58
YD-K30	TOP = 350.94
YD-K31	TOP = 350.45

1	Addenda 3 09.15.2025	
3	Addenda 6 10.14.2025	

AS-BUILT REVISIONS



The logo for K&W Engineers features a large, stylized 'K' and 'W' in blue, with a black ampersand in between. A thin black line extends from the top of the 'K' down to the top of the 'W'. Below the logo, the text 'DESIGNING ENVIRONMENTS' is written in a smaller, black, sans-serif font. To the right of the logo is the company's address: '2201 North Front Street, Suite 200 Harrisburg, PA 17110'. Below the address is the phone number 'P: 717.635.2835' and the website 'www.kandwengineers.com'.

HARRISBURG, PENNSYLVANIA

PLAZA PAVER REPAIR / REPLACEMENT PA STATE MUSEUM, THE CAPITOL COMPLEX

HARRISBURG, DAUPHIN COUNTY, PA

UTILITY PLAN

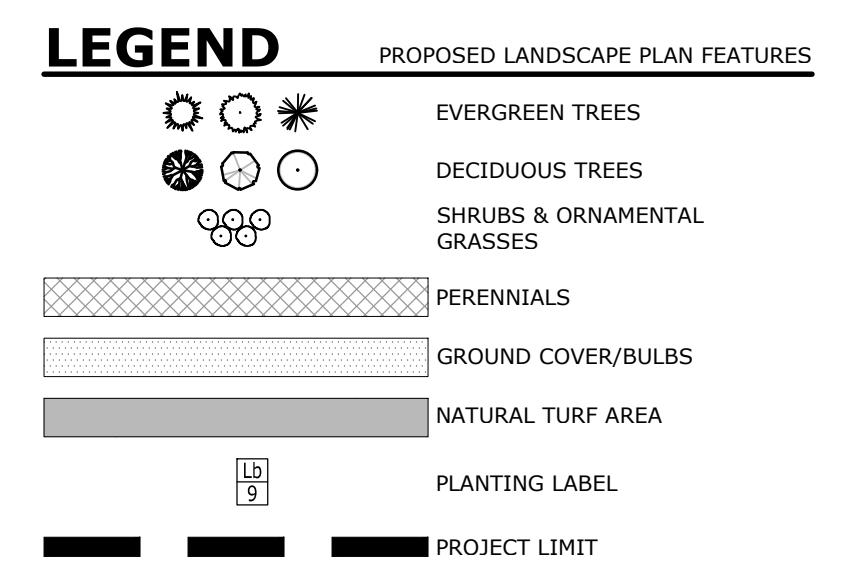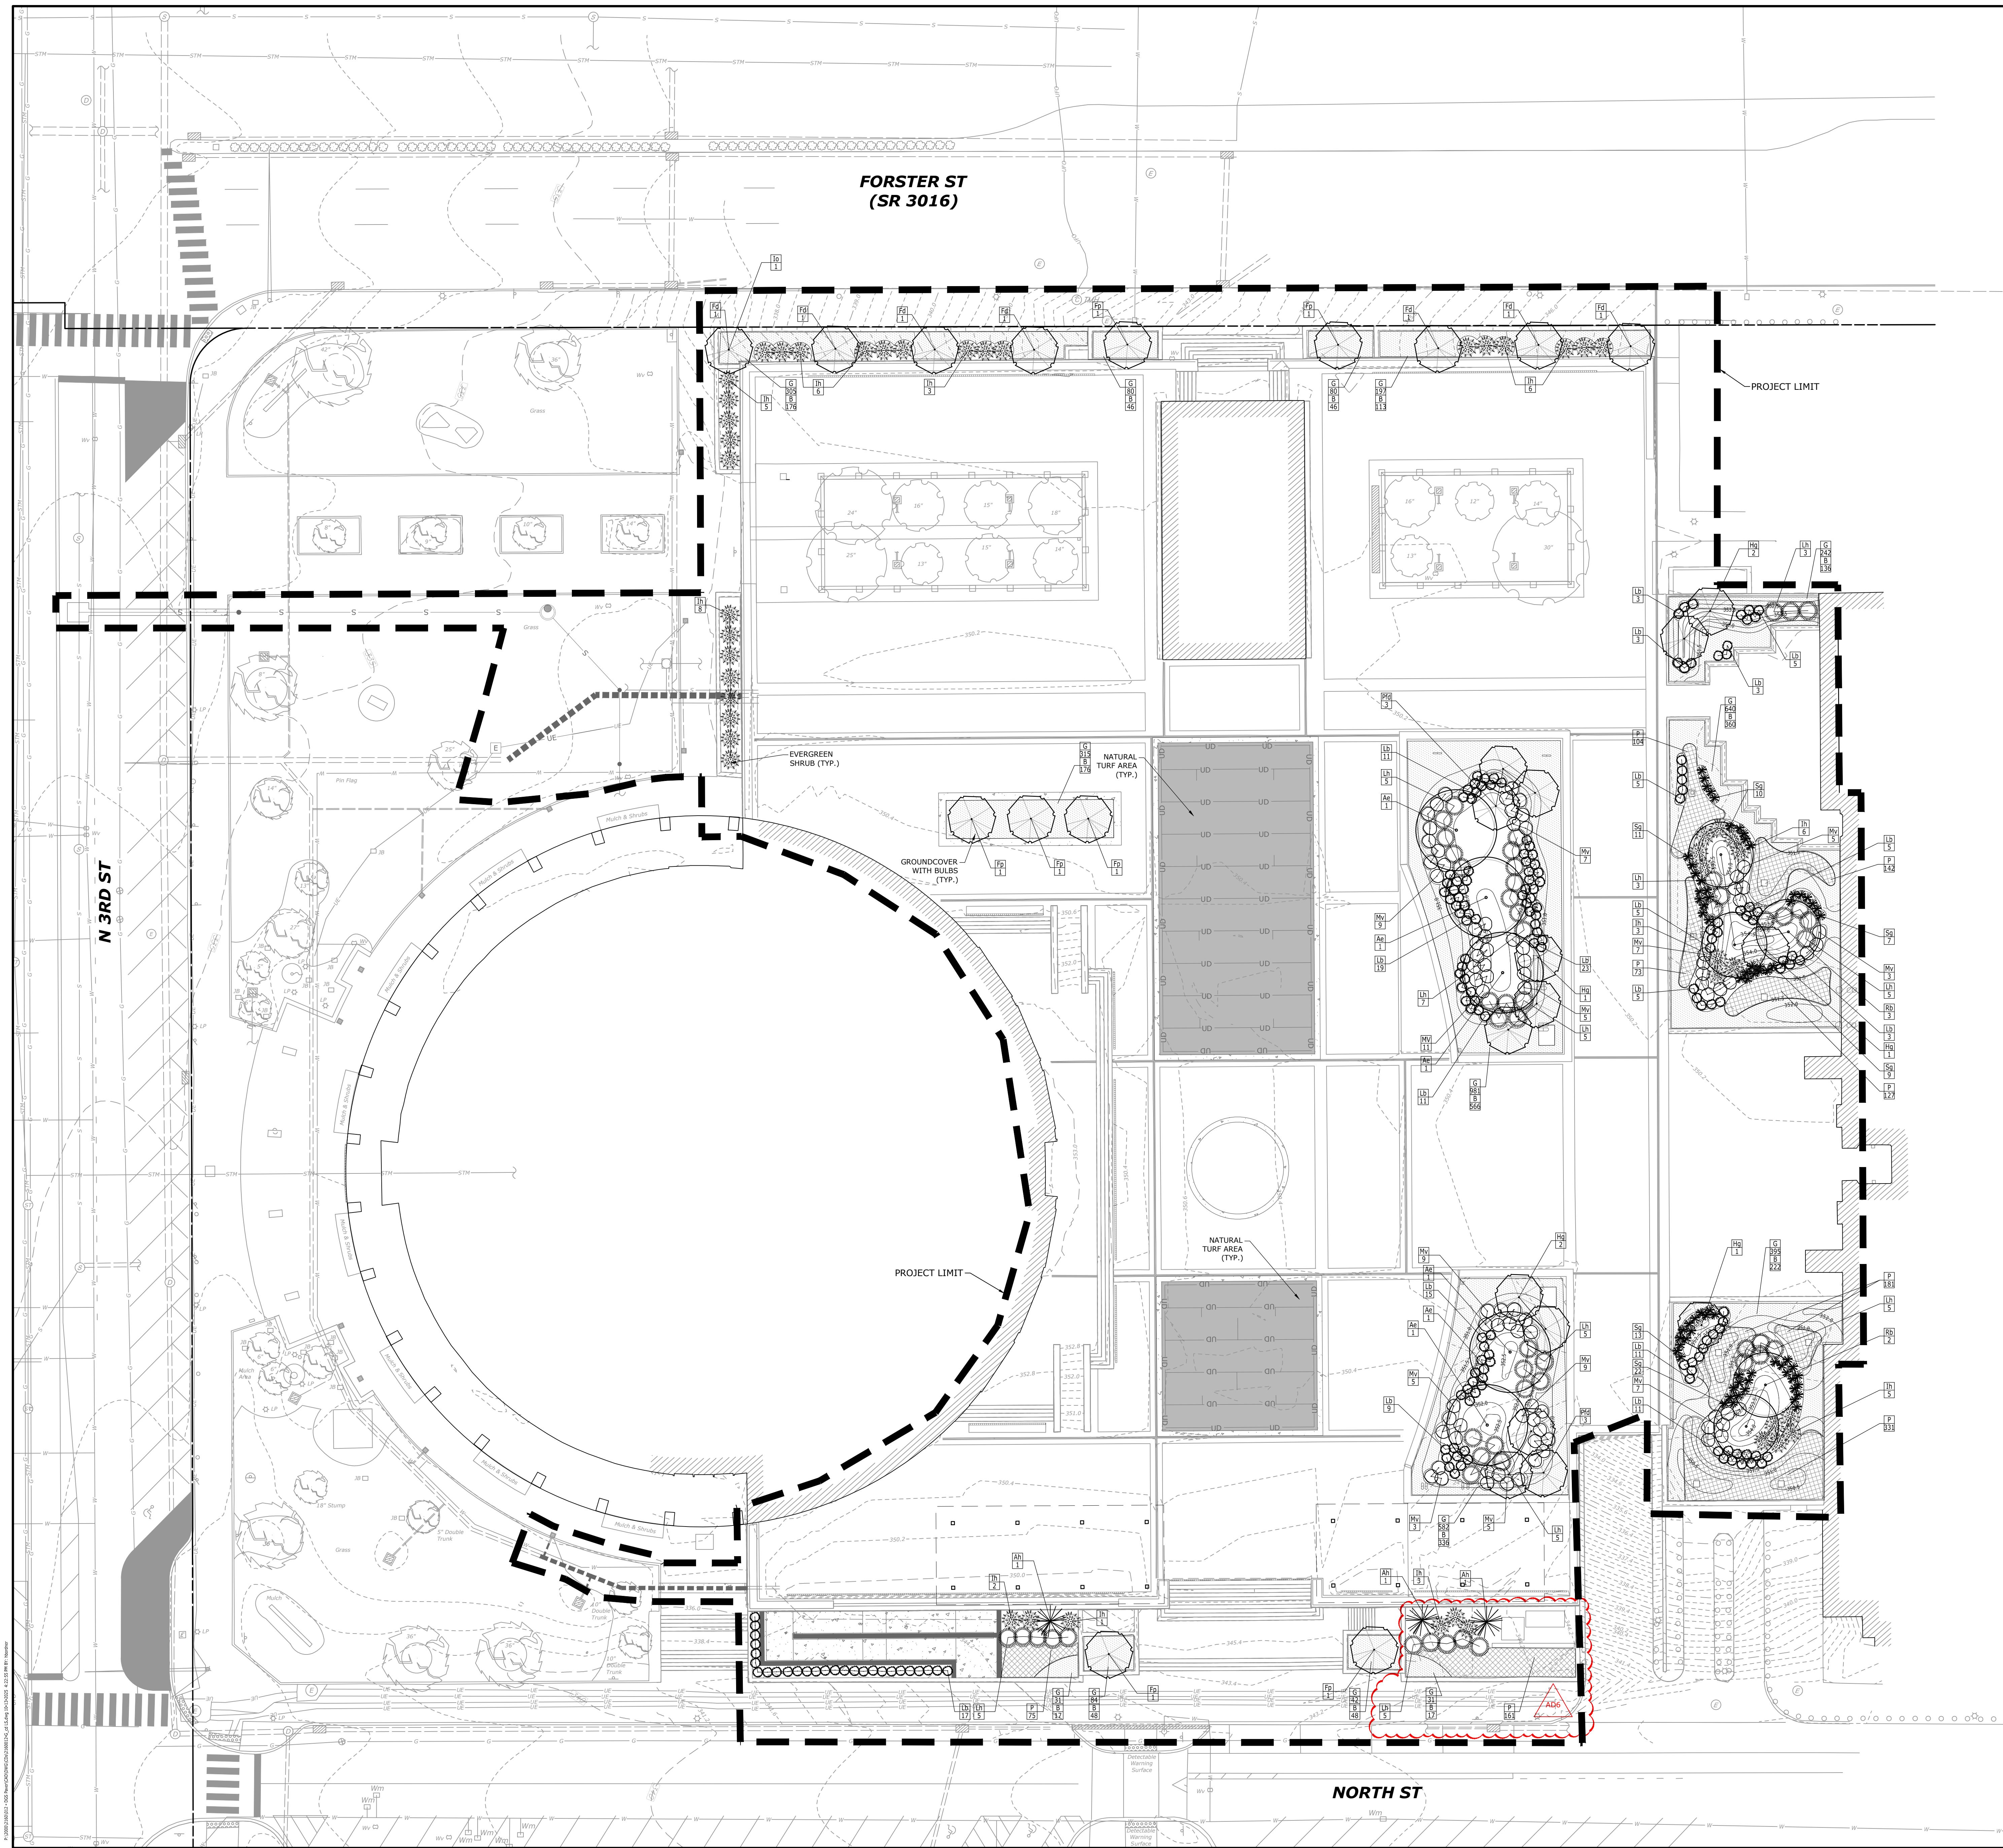

LEGEND

LANDSCAPE PLAN FEATURES

TREES			
Symbol	Botanical Name/ Common Plant Name	Quantity	Size
Ae	ULMUS AMERICANA AMERICAN ELM	6	2" CAL. B&B
Ah	ILEX OPACA AMERICAN HOLLY	3	6'-7" HT. B&B
Rb	BETULA NIGRA RIVER BIRCH	5	1.5" CAL. B&B
Fp	CERCIS CANADENSIS 'FOREST PANSY' FOREST PANSY REBUD	7	6'-7" HT. B&B
Hg	CERCIS CANADENSIS 'HEART OF GOLD' HEART OF GOLD REBUD	9	6'-7" HT. B&B
Fd	CORNUS FLORIDA FLOWERING DOGWOOD (WHITE FLOWERS)	7	6'-7" HT. B&B
Pfd	CORNUS FLORIDA 'RUBRA' PINK FLOWERING DOGWOOD	7	6'-7" HT. B&B

SHRUBS			
Symbol	Botanical Name/ Common Plant Name	Quantity	Size
Ih	ILEX GLabra INVERGREEN HOLLY	48	#3 GAL. B&B/ CONT.
Lh	ILEX VIRGINIANA 'SWEETSPINE' LITTLE HENRY SWEETSPINE	40	#3 GAL. B&B/ CONT.
Mv	Vaccinium 'SUNGOLD' MAPLELEAF VIBURNUM	103	#3 GAL. B&B/ CONT.

GRASSES, GROUND COVER & PERENNIALS			
Symbol	Botanical Name/ Common Plant Name	Quantity	Size
Lb	SCHIZACHYRIUM SCOPARIUM LITTLE BLUESTEM	164	#1 CONT.
Sg	PANICUM VIRGATUM 'CAPE BREEZE' CAPE BREEZE DWARF SWITCHGRASS	72	#1 CONT.
G	LIRIOPE MUSCARI 'ROYAL PURPLE' ROYAL PURPLE LIRIOPE	4,023	18" O.C.
B	NARCISSUS SP. WHITE MOUNT HOOD DAFFODILS	2,289	2" O.C. STAGGERED
P	RUDbeckia Hirta BLACK-EYED SUSAN	406	POT
	ECHINACEA PURPUREA PINK CONEFLOWER	406	POT
	HEMEROCALLIS 'HAPPY RETURNS' HAPPY RETURNS DAYLILY	406	18" O.C. VARY PLANTS

1 Addenda 3 09.15.2025
3 Addenda 6 10.14.2025

AS-BUILT REVISIONS

COMMONWEALTH OF PENNSYLVANIA
REGISTERED PROFESSIONAL
J. MARC KUROWSKI
ENGINEER
No. 0702024
PROFESSIONAL'S SIGNATURE DATE

K&V
DESIGNING ENVIRONMENTS

200 North Front Street, Suite 200
Harrisburg, PA 17110
P: 717.635.2835
www.kandvengineers.com

COMMONWEALTH OF PENNSYLVANIA
DEPARTMENT OF GENERAL SERVICES
HARRISBURG, PENNSYLVANIA

DGS PROJECT No. DGS 948-87 PHASE 1

PLAZA PAVER REPAIR / REPLACEMENT
PA STATE MUSEUM,
THE CAPITOL COMPLEX
HARRISBURG, DAUPHIN, PA

LANDSCAPE PLAN


VERIFY SCALE

BAR IS ONE (1) INCH LONG
ON ORIGINAL DRAWING:
0 1

IF BAR IS NOT ONE (1) INCH LONG,
ADJUST SCALE ACCORDINGLY

CONTRACTOR SHALL FIELD VERIFY
ALL DIMENSIONS
VARIED FROM CONTRACT
DOCUMENTS ARE UNPERMITTED
WITHOUT PROFESSIONAL & BUREAU
OF CONSTRUCTION APPROVAL

DRAWN BY HAB	DATE 11/08/2024	DRAWING NO. C-105
CHECKED BY JLL	SCALE PER DWG	

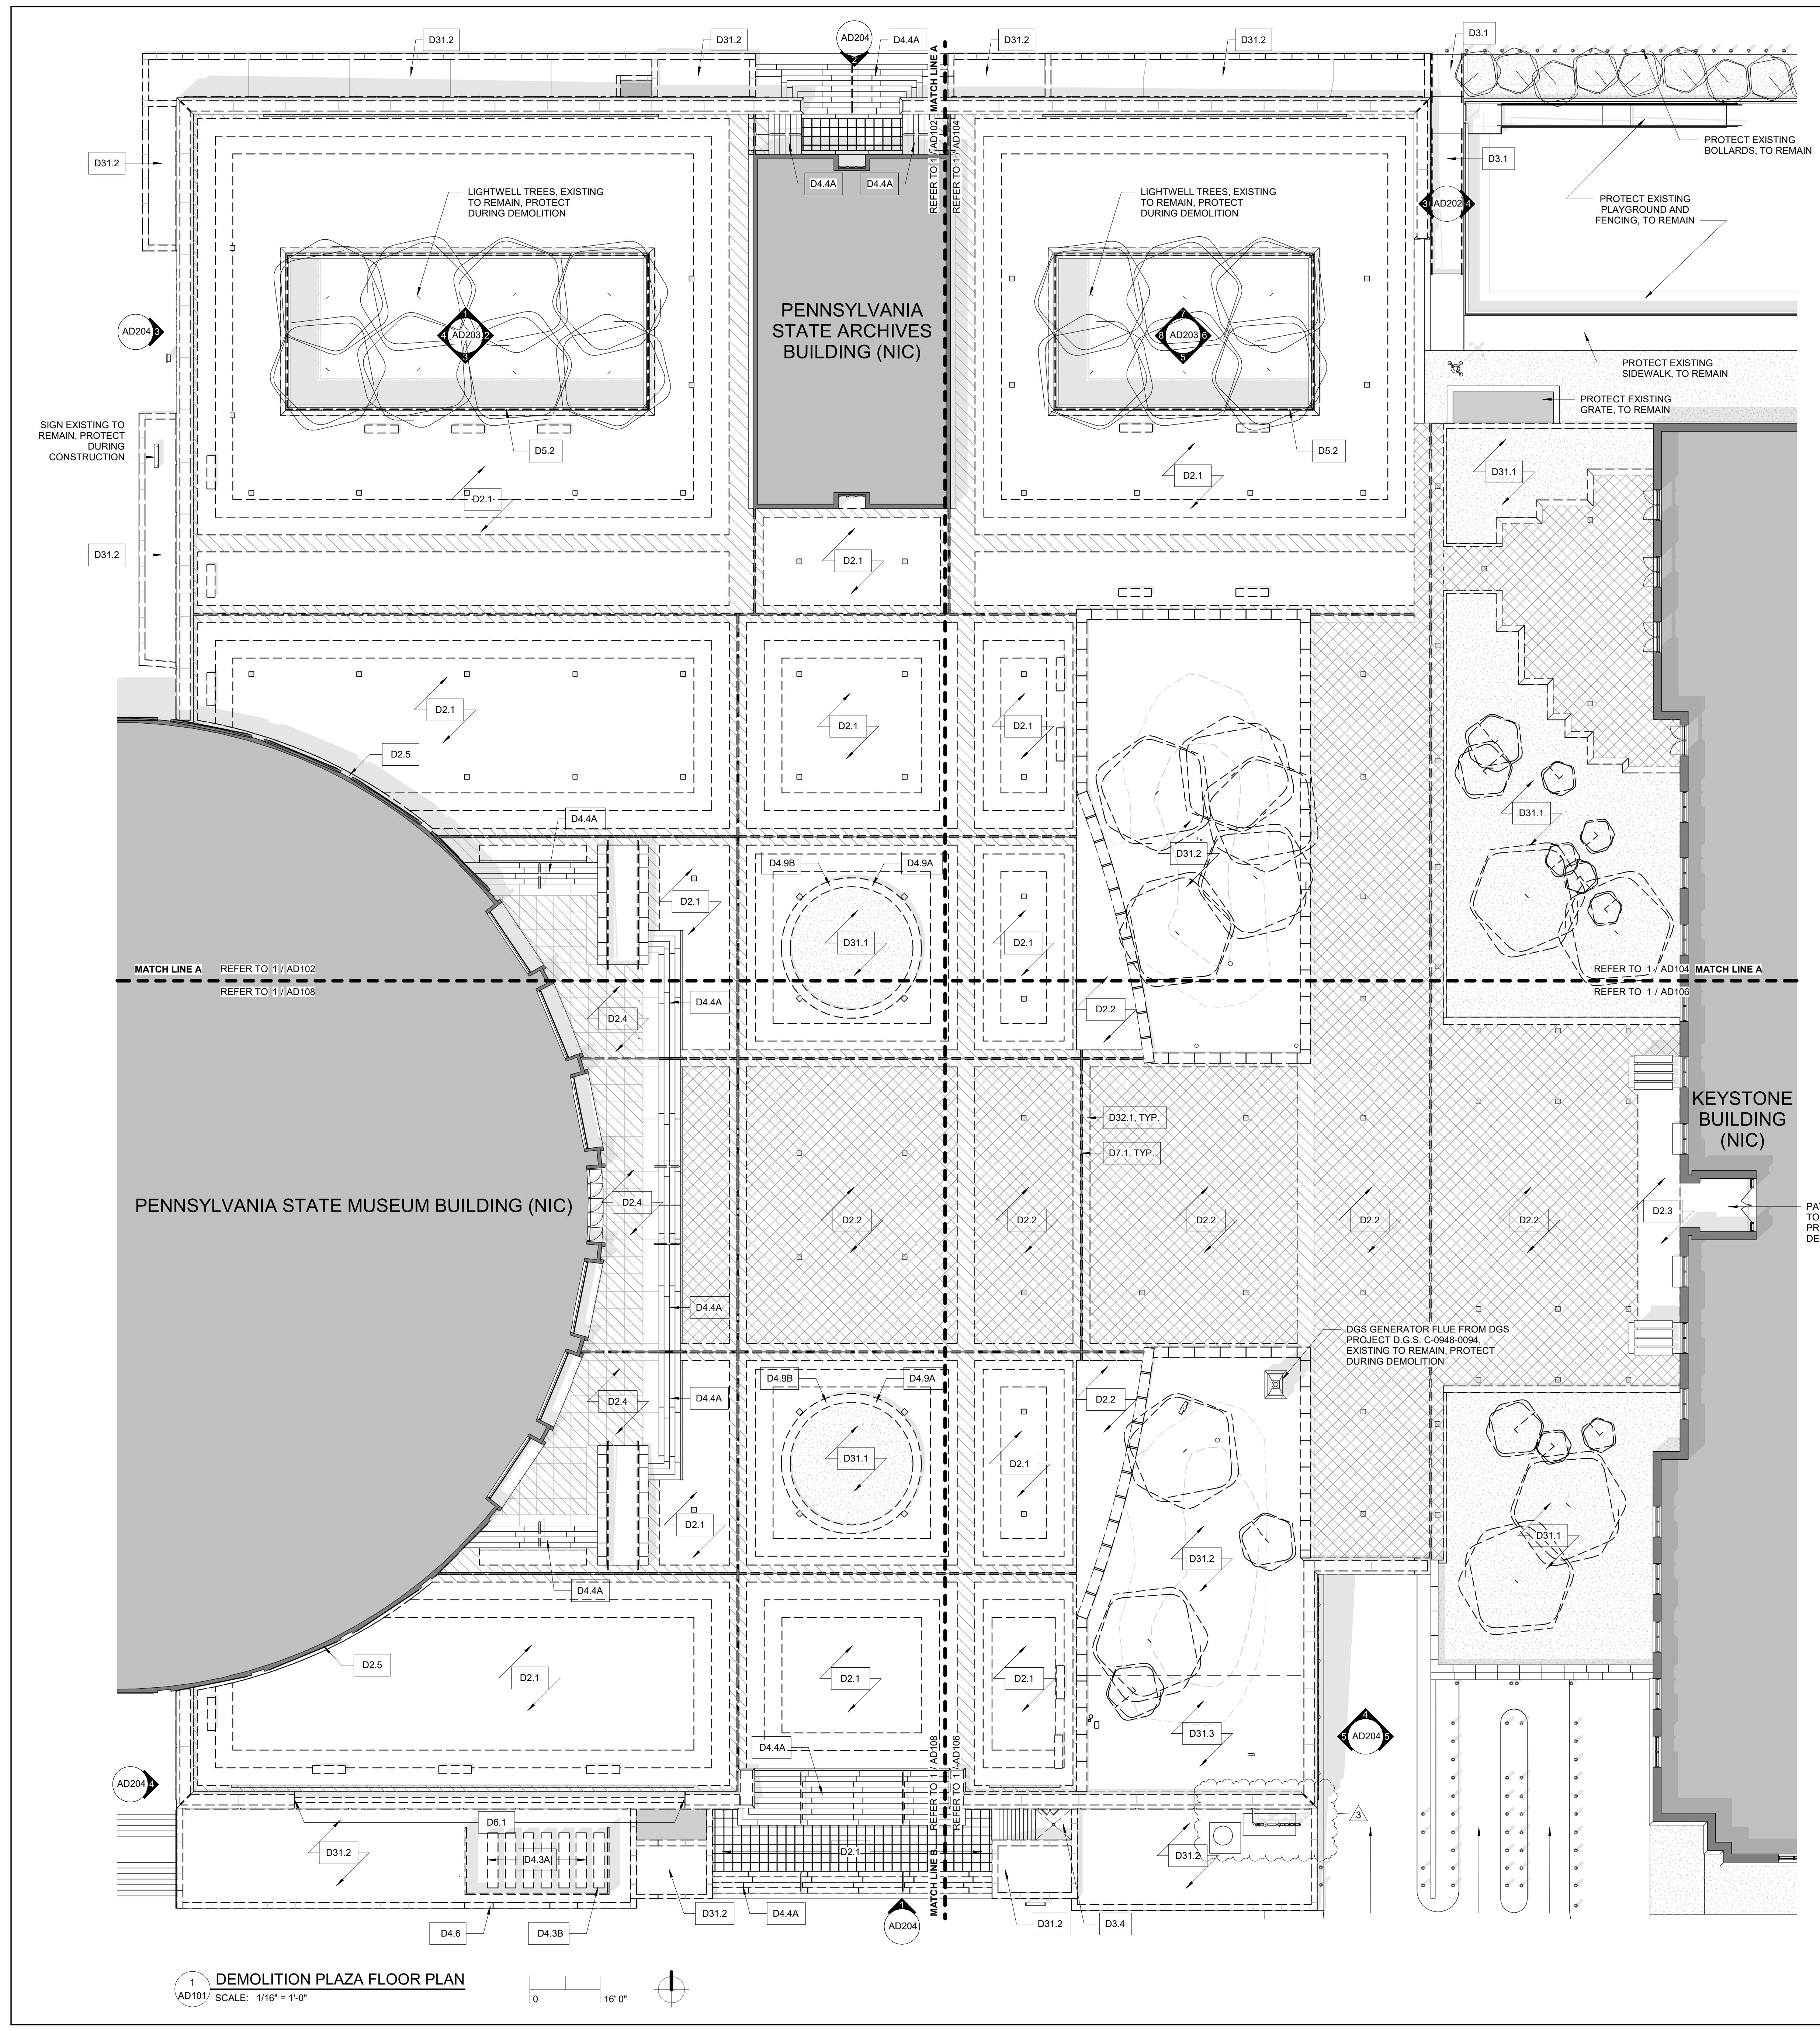

GENERAL DEMOLITION NOTES

1. SELECTIVE DEMOLITION WORK SHALL INCLUDE, BUT IS NOT LIMITED TO THE ITEMS LISTED ON THESE DRAWINGS. INCLUDE ALL THAT IS NECESSARY TO COMPLETE THE SCOPE OF WORK AS INDICATED ON THE CONSTRUCTION DRAWINGS AND SPECIFICATIONS. SEE ALL DRAWINGS TO COORDINATE ANY ADDITIONAL WALL OR FLOOR DEMOLITION.
2. NOT USED
3. NOTES ARE ORGANIZED UNDER THE MOST APPLICABLE SPECIFICATION SECTION.
4. COORDINATE DEMOLITION WITH DIMENSIONS OF NEW CONSTRUCTION.
5. CONTRACTOR TO INFORM ARCHITECT OF CONDITIONS INCONSISTENT WITH WHAT IS SHOWN ON DRAWINGS.
6. ====== INDICATES CONCRETE, MASONRY, OR STUD WALLS WITH FINISHES TO BE DEMOLISHED. PATCH ADJACENT SURFACES WITH MATERIALS TO MATCH EXISTING AND MINIMIZE INCONSISTENCIES.
7. NOT USED
8. PATCH AND REPAIR ALL AREAS Affected BY DEMOLITION. PREPARE THESE AREAS FOR NEW FINISH - SEE FINISH SCHEDULE.
9. REFER TO MECHANICAL, PLUMBING, AND ELECTRICAL DRAWINGS FOR DEMOLITION ASSOCIATED WITH MECHANICAL, PLUMBING, AND ELECTRICAL WORK.
10. REMOVE ALL FASTENERS, SUPPORTS, ETC. ASSOCIATED WITH DEMOLISHED ITEMS.
11. DEMOLITION CALLOUTS REFLECT MAJOR DEMOLITION ACTIVITIES. REFER TO ARCHITECTURAL AND WATERPROOFING DETAILS FOR MISC. CUTS, SCORES, AND CHAMFERS REQUIRED AT EXISTING STRUCTURE.
12. INTERNAL GUTTER SYSTEM LOCATED UNDER PLAZA EXPANSION JOINTS IS EXISTING TO REMAIN. PROTECT INTERNAL GUTTER SYSTEM DURING DEMOLITION.

DEMO NOTE KEY

DIV 2: DEMOLITION - PHASE 1.1 CONTRACTOR

- D2.1 REMOVE EXISTING EXPANSION JOINT AND ASSOCIATED COMPONENTS (IDENTIFIED BY LINE), REFER TO WATERPROOFING DEMOLITION DETAILS ON 10 / DM1.00, AND 3 / DM2.00.

DIV 9: FINISHES - PHASE 1.1 CONTRACTOR

- D9.1 REMOVE EXISTING HARD CEILING SYSTEM AS REQUIRED FOR NEW STORM WATER PIPING SCOPE
- D9.2 REMOVE EXISTING CEILING TILE AS REQUIRED FOR NEW STORM WATER PIPING SCOPE
- D9.3 DRYWALL PARTITION CONSTRUCTION TO BE REMOVED FROM FLOOR TO CEILING AS REQ'D TO ACCESS AND REMOVE STORMWATER PIPING AND CONNECTIONS.
- D9.4 REMOVE EXISTING EXTERIOR HARD CEILING SYSTEM AS REQUIRED FOR NEW STORM WATER PIPING SCOPE OR STRUCTURE.

DIV 10: SPECIALTIES - PHASE 1.1 CONTRACTOR

- D10.1 REMOVE EXISTING PLAQUE. TURN OVER TO CLIENT AGENCY.

DIV 12: FURNISHINGS - PHASE 1.1 CONTRACTOR

- D12.1 NOT USED
- D12.2 NOT USED
- D12.3 REMOVE STONE BENCHES. CATALOG, CLEAN, AND STORE, UNTIL READY FOR REINSTALLATION.

DIV 22: PLUMBING - PHASE 1.3 CONTRACTOR

- D22.1 REMOVE EXISTING DRAIN COVERS AND ASSEMBLY. COORD. DRAIN DEMO W/ PLUMBING DWGS. REFER TO WATERPROOFING DEMOLITION DETAILS ON 2 / DM1.00 AND 7 / DM2.00

DIV 31: EARTHWORK - PHASE 1.1 CONTRACTOR

- D31.1 REMOVE SOIL AND PLANTINGS. COORD. W/ CIVIL AND LANDSCAPE DWGS
- D31.2 REMOVE SOIL AND PLANTINGS AS REQ'D. FOR INSTALLATION OF SLAB ON GRADE AND COLUMN FOUNDATIONS

DIV 32: EXTERIOR IMPROVEMENTS - PHASE 1.1 CONTRACTOR

- D32.1 REMOVE GRANITE ACCENT PAVER. CLEAN, STORE, AND PREP TO REINSTALL. COORD. REFER TO A113 FOR RELOCATION DETAILS. (IDENTIFIED BY HATCH). WATERPROOFING DEMOLITION DETAILS ON 10 / DM1.00

1	Addenda 3	09/15/2025
2	Addenda 4	09/29/2025
3	Addenda 6	10/14/2025

AS-BUILT REVISIONS



CDA
CHRIS DAWSON ARCHITECT
300 NORTH 2ND STREET, SUITE 701, HARRISBURG, PA 17101

COMMONWEALTH OF PENNSYLVANIA
DEPARTMENT OF GENERAL SERVICES
HARRISBURG, PENNSYLVANIA

D.G.S. PROJECT No.

DGS 948-87 PHASE 1

PLAZA PAVER REPAIR / REPLACEMENT
PA STATE MUSEUM,
THE CAPITOL COMPLEX
HARRISBURG, DAUPHIN COUNTY, PA


DEMOLITION - PLAZA FLOOR PLAN

DRAWN BY DS DATE 07.29.25 DRAWING NO.

CHECKED BY WE SCALE PER DWG

AD101

DRAWING SET IS INTENDED FOR COLOR PRINTING

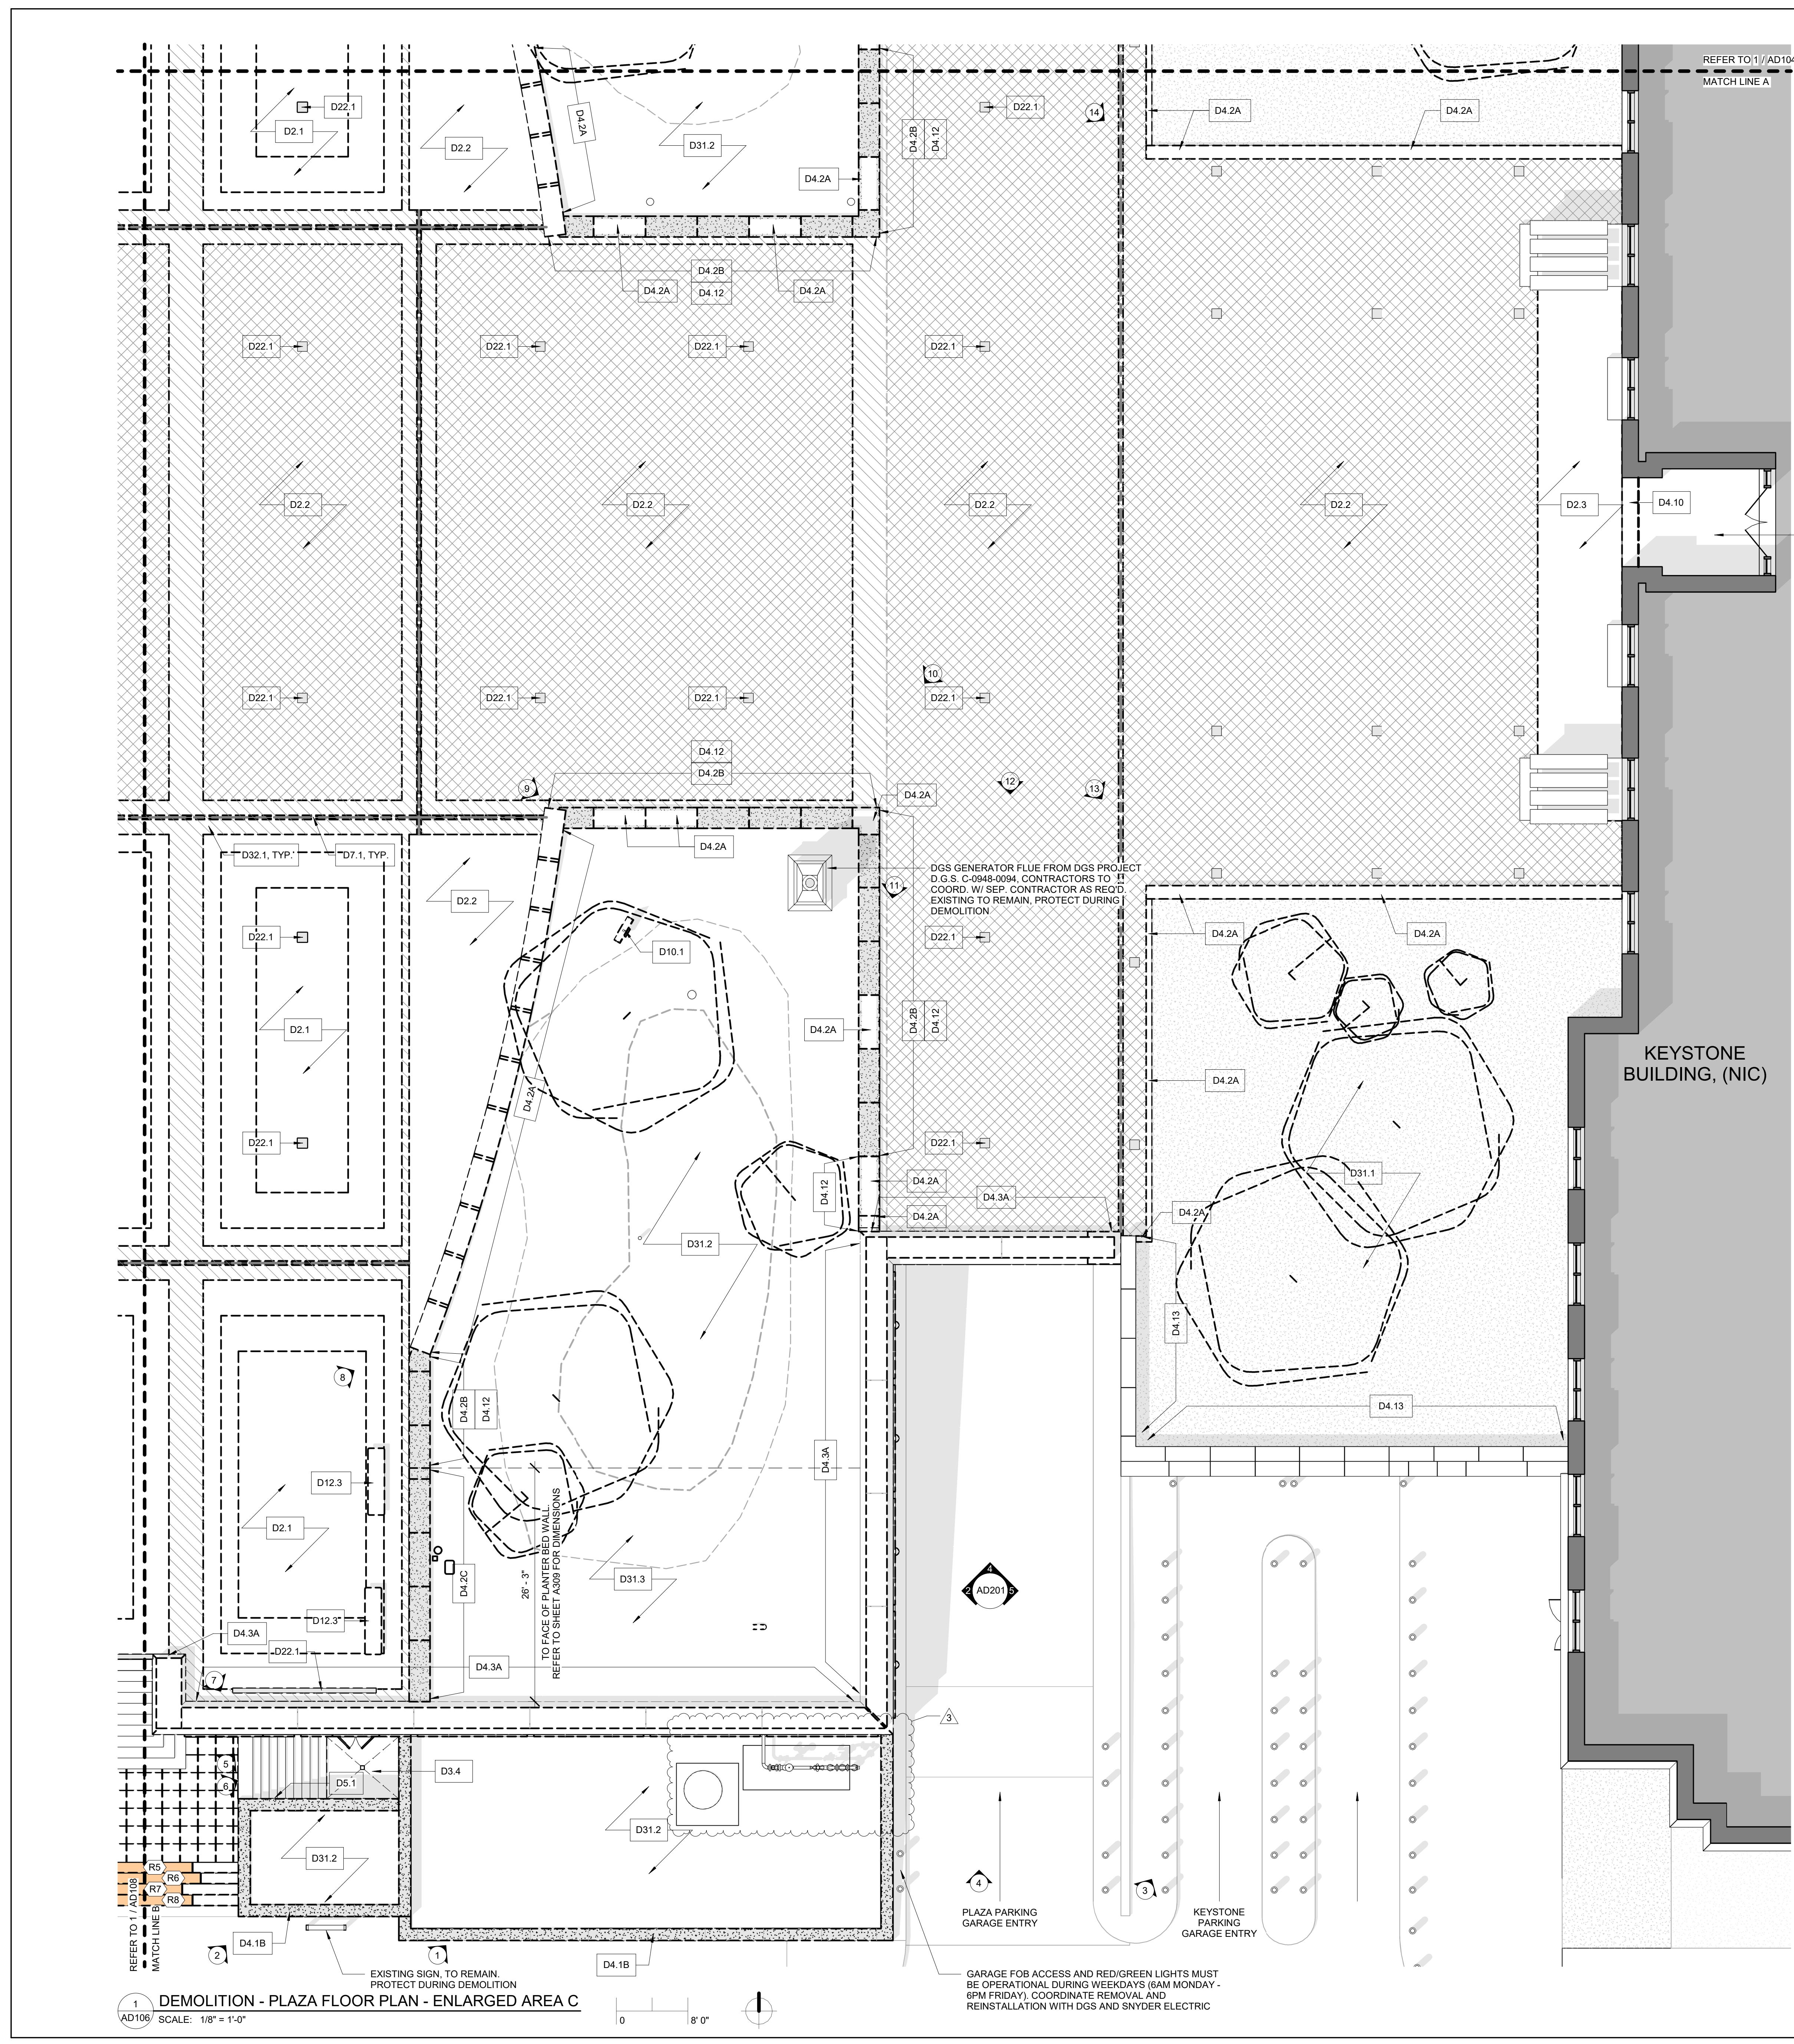

GENERAL DEMOLITION NOTES

1. SELECTIVE DEMOLITION WORK SHALL INCLUDE, BUT IS NOT LIMITED TO THE ITEMS LISTED ON THESE DRAWINGS. INCLUDE ALL THAT IS NECESSARY TO COMPLETE THE SCOPE OF WORK AS INDICATED ON THE CONSTRUCTION DRAWINGS AND SPECIFICATIONS. SEE ALL DRAWINGS TO COORDINATE ANY ADDITIONAL WALL OR FLOOR DEMOLITION.
2. NOT USED
3. NOTES ARE ORGANIZED UNDER THE MOST APPLICABLE SPECIFICATION SECTION.
4. COORDINATE DEMOLITION WITH DIMENSIONS OF NEW CONSTRUCTION.
5. CONTRACTOR TO INFORM ARCHITECT OF CONDITIONS INCONSISTENT WITH WHAT IS SHOWN ON DRAWINGS.
6. ====== INDICATES CONCRETE, MASONRY, OR STUD WALLS WITH FINISHES TO BE DEMOLISHED. PATCH ADJACENT SURFACES WITH MATERIALS TO MATCH EXISTING AND MINIMIZE INCONSISTENCIES.
7. NOT USED
8. PATCH AND REPAIR ALL AREAS AFFECTED BY DEMOLITION. PREPARE THESE AREAS FOR NEW FINISH - SEE FINISH SCHEDULE.
9. REFER TO MECHANICAL, PLUMBING, AND ELECTRICAL DRAWINGS FOR DEMOLITION ASSOCIATED WITH MECHANICAL, PLUMBING, AND ELECTRICAL WORK.
10. REMOVE ALL FASTENERS, SUPPORTS, ETC. ASSOCIATED WITH DEMOLISHED ITEMS.
11. DEMOLITION CALLOUTS REFLECT MAJOR DEMOLITION ACTIVITIES. REFER TO ARCHITECTURAL AND WATERPROOFING DETAILS FOR MISC. CUTS, SCORES, AND CHAMFERS REQUIRED AT EXISTING STRUCTURE.
12. INTERNAL GUTTER SYSTEM LOCATED UNDER PLAZA EXPANSION JOINTS IS EXISTING TO REMAIN. PROTECT INTERNAL GUTTER SYSTEM DURING DEMOLITION.

DEMO NOTE KEY

DIV 2: DEMOLITION - PHASE 1.1 CONTRACTOR

- D2.1 REMOVE CONCRETE PAVERS, CATALOG, CLEAN, AND STORE UNTIL READY FOR REINSTALLATION. REMOVE PEDESTALS, RIGID INSULATION, AND SLOPED CONCRETE TOPPING SLAB. AT COMPLETION OF DEMOLITION, STRUCTURAL DECK SHOULD BE BARE AND READY TO RECEIVE NEW WORK. REFER TO WATERPROOFING DEMOLITION DETAILS ON 1A / DM1.00.
- D2.2 REMOVE WHITE GRANITE PAVERS, CATALOG, CLEAN, AND STORE UNTIL READY FOR REINSTALLATION. REMOVE PEDESTALS, RIGID INSULATION, AND SLOPED CONCRETE TOPPING SLAB. AT COMPLETION OF DEMOLITION, STRUCTURAL DECK SHOULD BE BARE AND READY TO RECEIVE NEW WORK. REFER TO WATERPROOFING DEMOLITION DETAILS ON 1B / DM1.00 AND 3 / DM1.00.
- D2.3 REMOVE DARK GRANITE PAVERS, CATALOG, CLEAN, AND STORE UNTIL READY FOR REINSTALLATION. REMOVE PEDESTALS, RIGID INSULATION, AND SLOPED CONCRETE TOPPING SLAB. AT COMPLETION OF DEMOLITION, STRUCTURAL DECK SHOULD BE BARE AND READY TO RECEIVE NEW WORK. REFER TO WATERPROOFING DEMOLITION DETAILS ON 1B / DM1.00 AND 3 / DM1.00.
- D2.4 REMOVE GRANITE PAVERS, CATALOG, CLEAN, AND STORE UNTIL READY FOR REINSTALLATION. REMOVE RIGID INSULATION AND SLOPED CONCRETE TOPPING SLAB. AT COMPLETION OF DEMOLITION, STRUCTURAL DECK SHOULD BE BARE AND READY TO RECEIVE NEW WORK. REFER TO WATERPROOFING DEMOLITION DETAILS ON 1A / DM1.00.
- D2.5 REMOVE GRANITE STONE ANGLE AT WALL BASE, CATALOG, CLEAN, STORE, AND PREP FOR INSTALLATION. COORD. WITH WATERPROOFING DETAIL 7 / DM1.00.

DIV 3: CONCRETE - PHASE 1.1 CONTRACTOR

- D3.1 REMOVE REINFORCED CONCRETE RAMP.
- D3.2 NOT USED
- D3.3 REMOVE FLOOR AND ASSOCIATED FINISHES AS NECESSARY TO ACCESS STORMWATER DRAIN BELOW. REPLACE TO MATCH EXISTING (BASE BID 2 IDENTIFIED BY HATCH [REDACTED]) (BASE BID 3 IDENTIFIED BY HATCH [REDACTED])
- D3.4 REMOVE CONCRETE SLAB. REFER TO WATERPROOFING DEMOLITION DETAILS ON 1 / DM3.00.

DIV 4: MASONRY - PHASE 1.1 CONTRACTOR

- D4.1A REMOVE LIMESTONE PANEL, CATALOG, CLEAN, STORE AND PREP TO REINSTALL. REFER TO WATERPROOFING DEMOLITION DETAIL ON 5 / DM1.00, 2 / DM1.00, AND 27 / DM2.00.
- D4.1B REMOVE LIMESTONE PANEL (IDENTIFIED BY HATCH [REDACTED]) REFER TO WATERPROOFING DEMOLITION DETAIL ON 5 / DM1.00, 27 / DM0.00, AND 27 / DM2.00.
- D4.2A REMOVE GRANITE PLANTER WALLS, CATALOG, CLEAN, STORE AND PREP TO REINSTALL. REFER TO WATERPROOFING DEMOLITION DETAIL ON 1 / DM2.00 AND 5 / DM2.00.
- D4.2B REMOVE GRANITE PLANTER WALLS (IDENTIFIED BY HATCH [REDACTED]) REFER TO WATERPROOFING DEMOLITION DETAILS ON 1 / DM2.00 AND 5 / DM2.00.
- D4.2C REMOVE GRANITE PLANTER WALLS, INCLUDING CONCRETE SUB WALLS. COORD. SUBWALL REMOVAL W/ EXTENT OF NEW WORK IDENTIFIED BY HATCH [REDACTED] REFER TO WATERPROOFING DEMOLITION DETAILS ON 1 / DM2.00 AND 5 / DM2.00.
- D4.3A REMOVE EXISTING LIMESTONE PANELS AND ASSOC. BASE STONE. CATALOG, CLEAN, STORE AND PREP TO REINSTALL REFER TO WATERPROOFING DEMOLITION DETAILS ON 2 / DM1.00. IF BLOCK OR SUPPORT IS UNSALVAGEABLE, CONTACT ARCHITECT AND ENGINEER FOR REVIEW AND REPAIR SPECIFICATIONS.
- D4.3B STONE BLOCK TO BE SALVAGED AND RETURNED TO CLIENT AGENCY. WATERPROOFING DEMOLITION DETAILS ON 2 / DM1.00.
- D4.4A REMOVE GRANITE STAIR PAVERS (RISERS & TREADS), CATALOG, CLEAN, STORE AND PREP FOR REINSTALLATION / RELOCATION. REFER TO A113 FOR RELOCATION DETAILS. WATERPROOFING DEMOLITION DETAILS ON 7 / DM2.00.
- D4.4B REMOVE GRANITE STAIR PAVERS (RISERS & TREADS). (IDENTIFIED BY HATCH [REDACTED]) WATERPROOFING DEMOLITION DETAILS ON 7 / DM2.00.
- D4.5A REMOVE EXISTING LIMESTONE COPING, CATALOG, CLEAN, STORE AND PREP TO REINSTALL. WATERPROOFING DEMOLITION DETAILS ON 2 / DM1.00.
- D4.5B REMOVE EXISTING LIMESTONE COPING (IDENTIFIED BY HATCH [REDACTED]) WATERPROOFING DEMOLITION DETAILS ON 2 / DM1.00.
- D4.6 REMOVE LIMESTONE PLANTER WALLS, INCLUDING CONCRETE SUB WALLS. SALVAGE LIMESTONE FOR REUSE. COORD. EXTENT W/ NEW WORK.
- D4.7 CMU WALL CONSTRUCTION TO BE REMOVED AS REQD. TO ACCESS & REMOVE STORMWATER PIPING & CONNECTIONS OR TO INSTALL ACCESS PANEL.
- D4.8 BRICK INFILL WITHIN CMU WALL CONSTRUCTION TO BE REMOVED FROM FLOOR TO CEILING AS REQD TO ACCESS AND REMOVE STORMWATER PIPING AND CONNECTIONS.
- D4.9A REMOVE GRANITE PLANTER COPING AND CLADDING. REFER TO WATERPROOFING DEMOLITION DETAILS ON 4 / DM2.00. RETURN TO CLIENT AGENCY.
- D4.9B REMOVE PLANTER CONCRETE SUB WALLS. REFER TO WATERPROOFING DEMOLITION DETAILS ON 4 / DM2.00.
- D4.10 REMOVE GRANITE PAVERS, CATALOG, CLEAN, STORE, AND PREP TO REINSTALL. REFER TO WATERPROOFING DEMOLITION DETAIL 4 / DM1.00.
- D4.11 REMOVE GRANITE CURB, CATALOG, CLEAN, STORE, AND PREP TO REINSTALL. REFER TO DEMOLITION DETAIL ON 6 / DM1.00.
- D4.12 REMOVE CONCRETE MASONRY WALLS SURROUNDING THE PLANTER. REFER TO WATERPROOFING DEMOLITION DETAIL 5 / DM2.00.
- D4.13 REMOVE GRANITE COPING AND GRANITE PANELS ON BOTH SIDES OF PLANTER. WEIGHT NOTATED ON ELEVATIONS OR LOCATION SHOWN ON PROPOSED DETAIL 1 / A504, & 2 / A504. CATALOG, CLEAN, STORE AND PREP TO REINSTALL.

DIV 5: METALS - PHASE 1.1 CONTRACTOR

- D5.1 REMOVE EXISTING HANDRAIL AND RELATED ACCESSORIES INCLUDING SLEEVES.
- D5.2 REMOVE EXISTING METAL HANDRAIL, CATALOG, CLEAN, MODIFY REFER TO DETAIL DWG 6 / A501. STORE, AND PREP TO REINSTALL.

DIV 6: WOOD, PLASTICS, AND COMPOSITES - PHASE 1.1 CONTRACTOR

- D6.1 REMOVE EXISTING TEMPORARY WD./MTL. RAILING
- D6.2 REMOVE TEMPORARY WOOD WALLS
- D6.3 REMOVE TEMPORARY WOOD BRACING. COORDINATE WITH REMOVAL OF STONE SOFFIT

VERIFY SCALE

BAR IS ONE (1) INCH LONG
ON ORIGINAL DRAWING:
0 1

IF BAR IS NOT ONE (1) INCH LONG,
ADJUST SCALE ACCORDINGLY

CONTRACTOR SHALL FIELD VERIFY
ALL DIMENSIONS
VARIATIONS FROM CONTRACT
DOCUMENTS NOT PERMITTED
WITHOUT PROFESSIONAL & BUREAU
OF CONSTRUCTION APPROVAL

DIV 7: THERMAL AND MOISTURE PROTECTION - PHASE 1.1 CONTRACTOR
D7.1 REMOVE EXISTING EXPANSION JOINT AND ASSOCIATED
COMPONENTS (IDENTIFIED BY LINE [REDACTED]) REFER
TO WATERPROOFING DEMOLITION DETAILS ON 10 / DM1.00,
AND 3 / DM2.00.

DIV 8: FINISHES - PHASE 1.1 CONTRACTOR
D8.1 REMOVE EXISTING CEILING TILE AS REQUIRED FOR NEW STORM
WATER PIPING SCOPE
D8.2 REMOVE EXISTING CEILING TILE AS REQUIRED FOR NEW STORM
WATER PIPING SCOPE
D8.3 DRYWALL PARTITION CONSTRUCTION TO BE REMOVED FROM FLOOR TO
CEILING AS REQD TO ACCESS AND REMOVE STORMWATER PIPING AND
CONNECTIONS.
D8.4 REMOVE EXISTING EXTERIOR HARD CEILING SYSTEM AS REQUIRED FOR
NEW STORM WATER PIPING SCOPE OR STRUCTURE.


DIV 10: SPECIALTIES - PHASE 1.1 CONTRACTOR

D10.1 REMOVE EXISTING PLAQUE. TURN OVER TO CLIENT AGENCY.
D12: FURNISHINGS - PHASE 1.1 CONTRACTOR
D12.1 NOT USED
D12.2 NOT USED
D12.3 REMOVE STONE BENCHES. CATALOG, CLEAN, AND STORE, UNTIL READY
FOR REINSTALLATION.

DIV 22: PLUMBING - PHASE 1.1 CONTRACTOR
D22.1 REMOVE EXISTING DRAIN COVERS AND ASSEMBLY. COORD. DRAIN DEMO
W/ PLUMBING DWGS. REFER TO WATERPROOFING DEMOLITION DETAILS ON
2 / DM1.00 AND 7 / DM2.00.


DIV 31: EARTHWORK - PHASE 1.1 CONTRACTOR
D31.1 REMOVE SOIL AND PLANTINGS. COORD. W/ CIVIL AND LANDSCAPE DWGS
D31.2 REMOVE SOIL AND PLANTINGS TO DEPTH COORD. W/ CIVIL DWGS.
D31.3 REMOVE SOIL AND PLANTINGS AS REQD. FOR INSTALLATION OF SLAB ON
GRADE AND COLUMN FOUNDATIONS

DIV 32: EXTERIOR IMPROVEMENTS - PHASE 1.1 CONTRACTOR
D32.1 REMOVE GRANITE ACCENT PAVER. CLEAN, STORE, AND PREP TO
REINSTALL. COORD. REFER TO A113 FOR RELOCATION DETAILS.
(IDENTIFIED BY HATCH [REDACTED]) WATERPROOFING
DEMOLITION DETAILS ON 10 / DM1.00

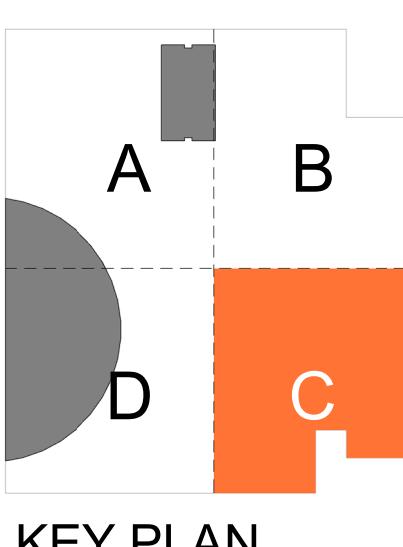

1	Addenda 3	09/15/2025
2	Addenda 4	09/29/2025
3	Addenda 6	10/14/2025

AS-BUILT REVISIONS

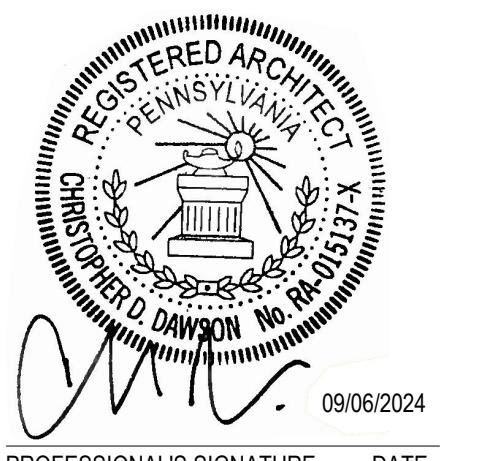


CDA
CHRIS DAWSON ARCHITECT
300 NORTH 2ND STREET, SUITE 701, HARRISBURG, PA 17101

COMMONWEALTH OF PENNSYLVANIA
DEPARTMENT OF GENERAL SERVICES
HARRISBURG, PENNSYLVANIA
D.G.S. PROJECT No. DGS 948-87 PHASE 1


PLAZA PAVER REPAIR / REPLACEMENT
PA STATE MUSEUM,
THE CAPITOL COMPLEX
HARRISBURG, DAUPHIN COUNTY, PA
DEMOLITION - PLAZA FLOOR PLAN - ENLARGED AREA C


DRAWN BY DS DATE 07.29.25 DRAWING NO.
CHECKED BY WE SCALE PER DWG
AD106

 DRAWING SET IS INTENDED FOR COLOR PRINTING



 DRAWING SET IS INTENDED FOR COLOR PRINTING



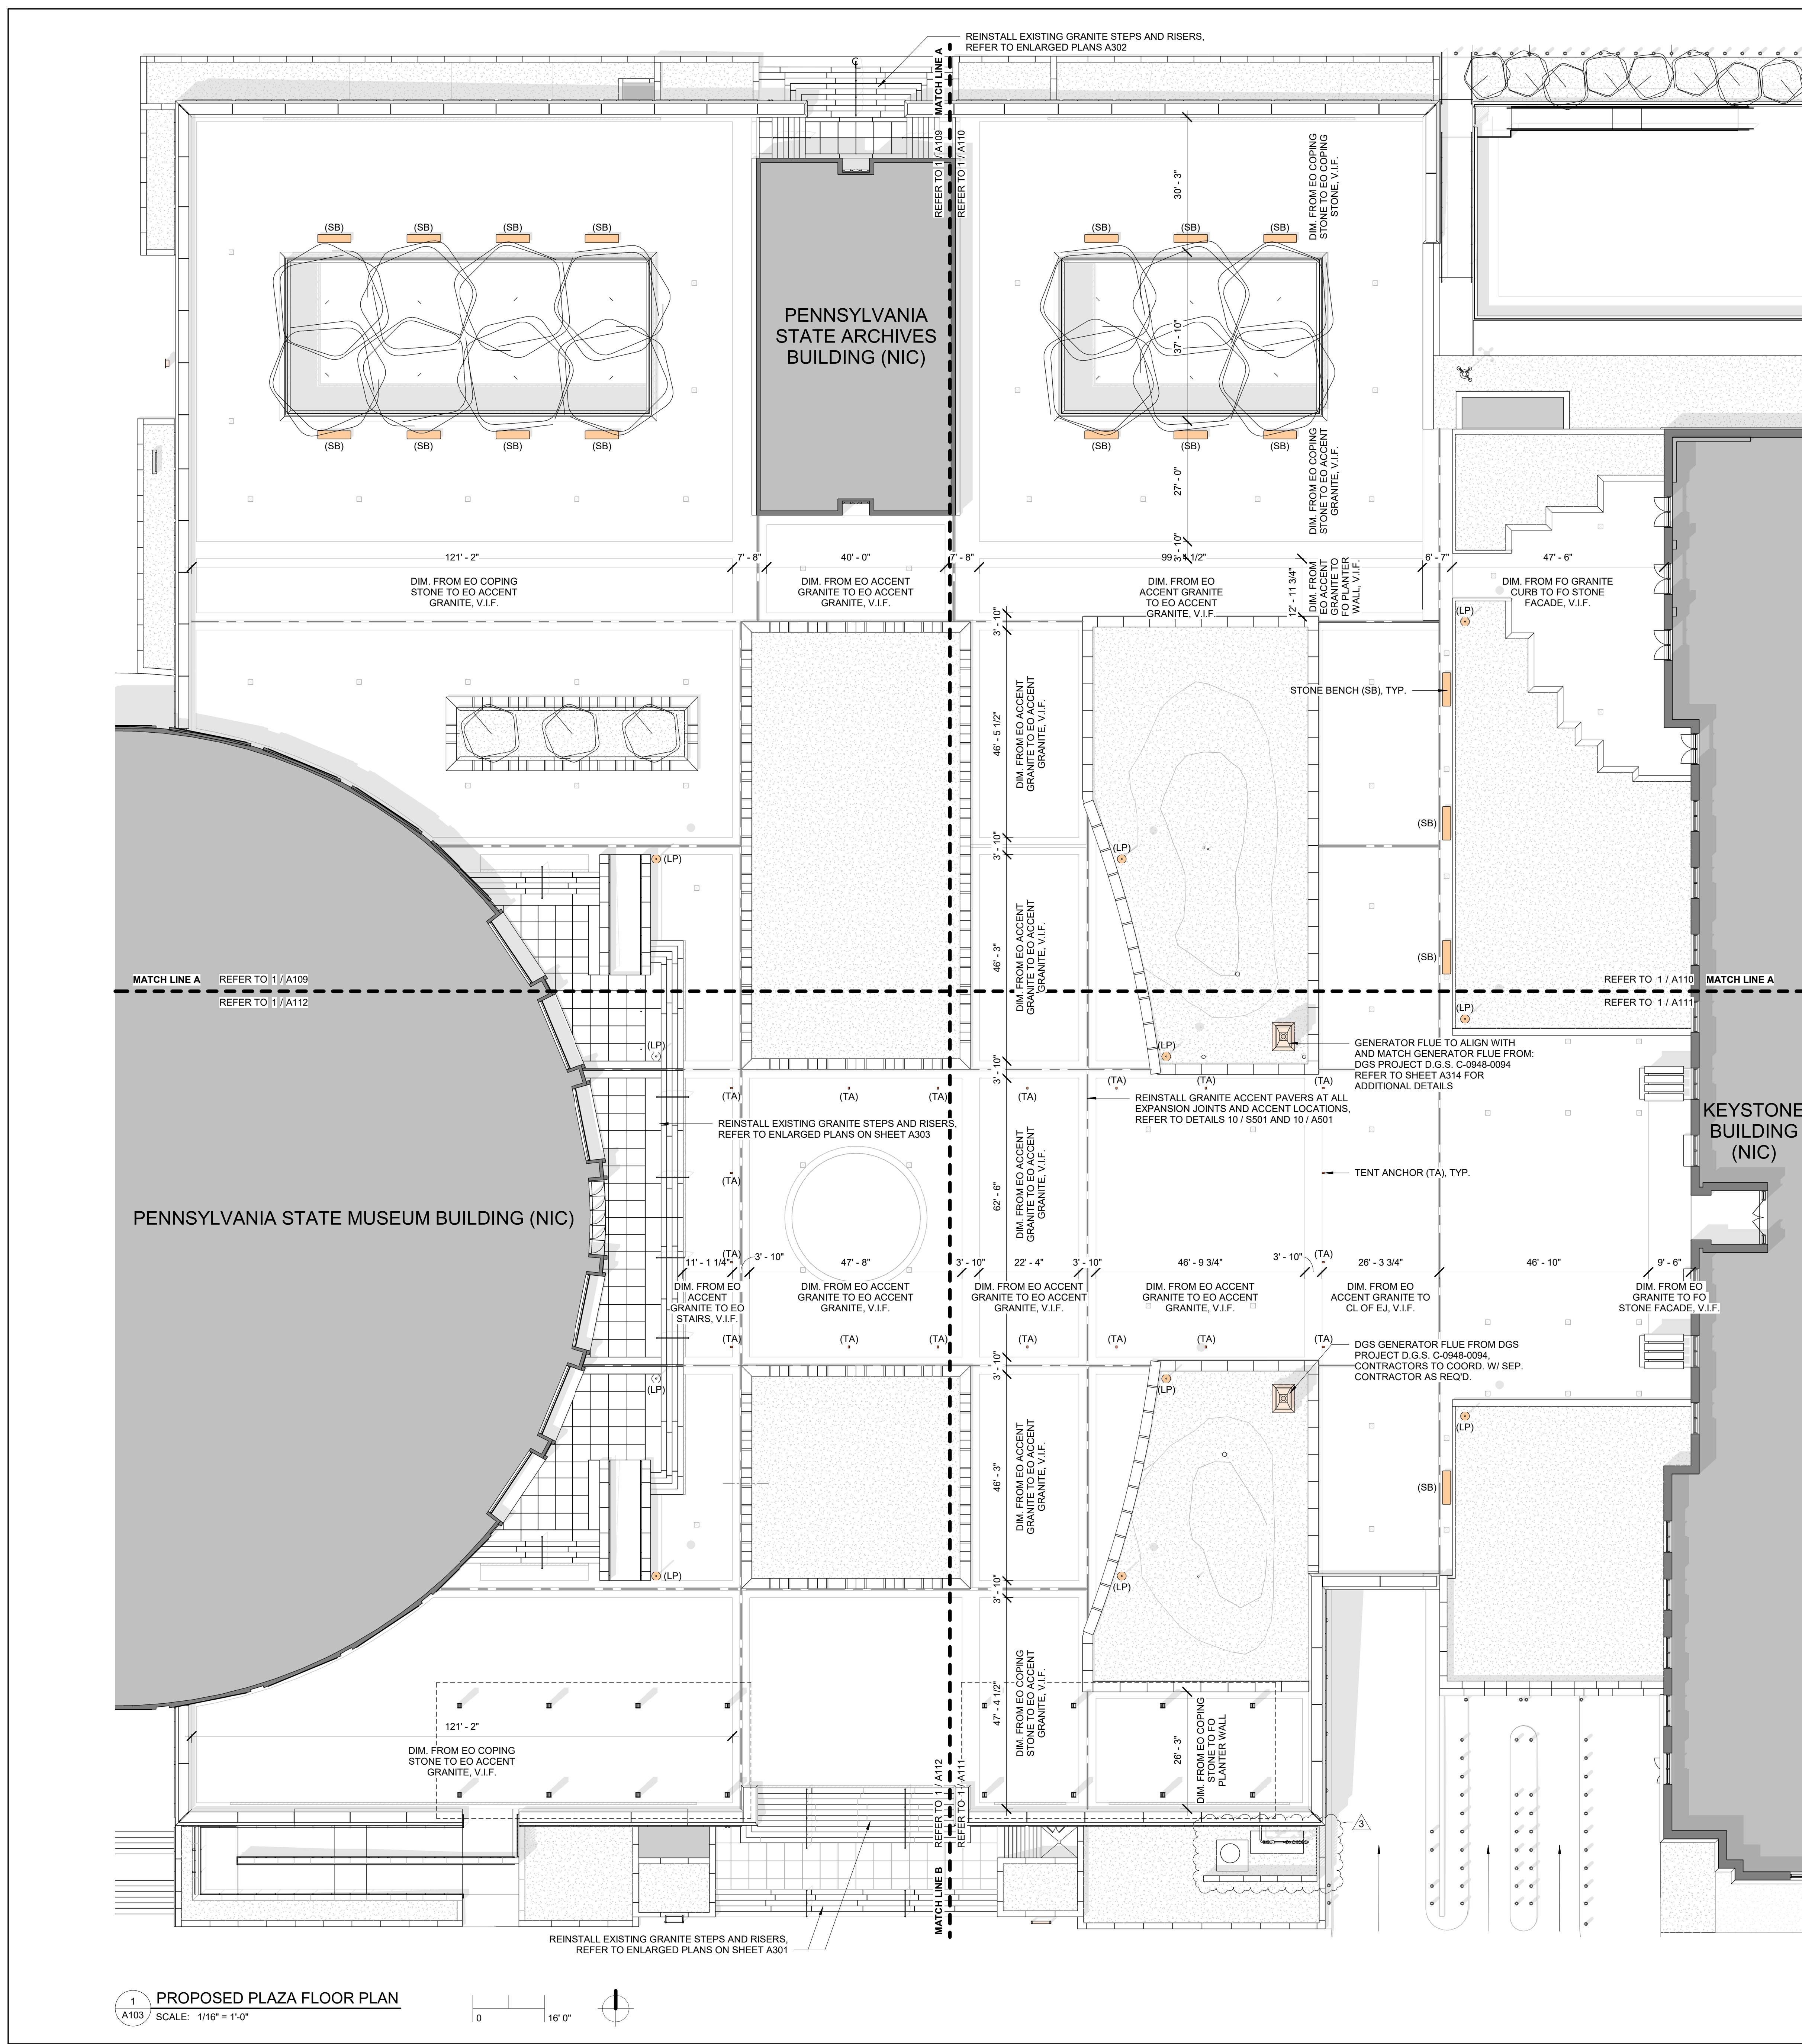

GENERAL PLAN NOTES	
1. DIMENSIONS ARE FROM FACE OF FINISH, FACE OF MASONRY, OR CENTERLINE OF COLUMN	
2. DIMENSIONS SHOWN ARE TO BE VERIFIED IN FIELD. PAVER DIMENSIONS ARE TO MATCH EXISTING. NOTIFY ARCHITECT IF DIMENSIONS VARY.	
3. REFER TO SHEET S510 FOR TYPICAL WATERPROOFING DETAILS.	
PROPOSED PLAN KEY	
(SB) LOCATION OF EXPANSION JOINTS, REFER TO DETAILS 10 / S501 AND 10 / A501, TYP.	
(SB) LOCATION OF STONE BENCHES, REFER TO DETAIL 3 / S503 AND 3 / A503, TYP.	
(LP) LOCATION OF AREA DRAINS, REFER TO DETAILS 2 / S501 AND 2 / A501, TYP. REFER TO PLUMBING DWGS.	
(TA) LOCATION OF TRENCH DRAINS, REFER TO DETAILS 2 / S501, 1 / S510 AND 2 / A501, TYP. REFER TO PLUMBING DWGS.	
(TA) LOCATION OF TENT ANCHORS, REFER TO DETAILS 6 / S502 AND 6 / A502, TYP.	
(LP) LOCATION OF LIGHT POLES, REFER TO DETAILS 5 / S501, 7 / S504, 5 / A501, AND 7 / A504, TYP.	
(MM) LOCATION OF REPLACED PLANTER STONE, REFER TO DETAILS 5 / S502, 5 / A502, REFER TO SHEET A500 FOR TYP. STONE DIMS.	

3	Addenda 6	10/14/2025
AS-BUILT REVISIONS		
 <p>09/06/2024 PROFESSIONAL'S SIGNATURE DATE</p>		

CDA
CHRIS DAWSON ARCHITECT

300 NORTH 2ND STREET, SUITE 701, HARRISBURG, PA 17101

COMMONWEALTH OF PENNSYLVANIA
DEPARTMENT OF GENERAL SERVICES

HARRISBURG, PENNSYLVANIA

D.G.S. PROJECT No.

DGS 948-87 PHASE 1


PLAZA PAVER REPAIR / REPLACEMENT
PA STATE MUSEUM,
THE CAPITOL COMPLEX
HARRISBURG, DAUPHIN COUNTY, PA

PLAZA FLOOR PLAN

VERIFY SCALE		
BAR IS ONE (1) INCH LONG ON ORIGINAL DRAWING:	0	1
IF BAR IS NOT ONE (1) INCH LONG, ADJUST SCALE ACCORDINGLY		
CONTRACTOR SHALL FIELD VERIFY ALL DIMENSIONS VARIOUS CONTRACT DOCUMENTS NOT PERMITTED WITHOUT PROFESSIONAL & BUREAU OF CONSTRUCTION APPROVAL	DRAWN BY DS CHECKED BY WE	DATE 07.29.25 SCALE PER DWG
		DRAWING NO.

A103


DRAWING SET IS INTENDED FOR COLOR PRINTING

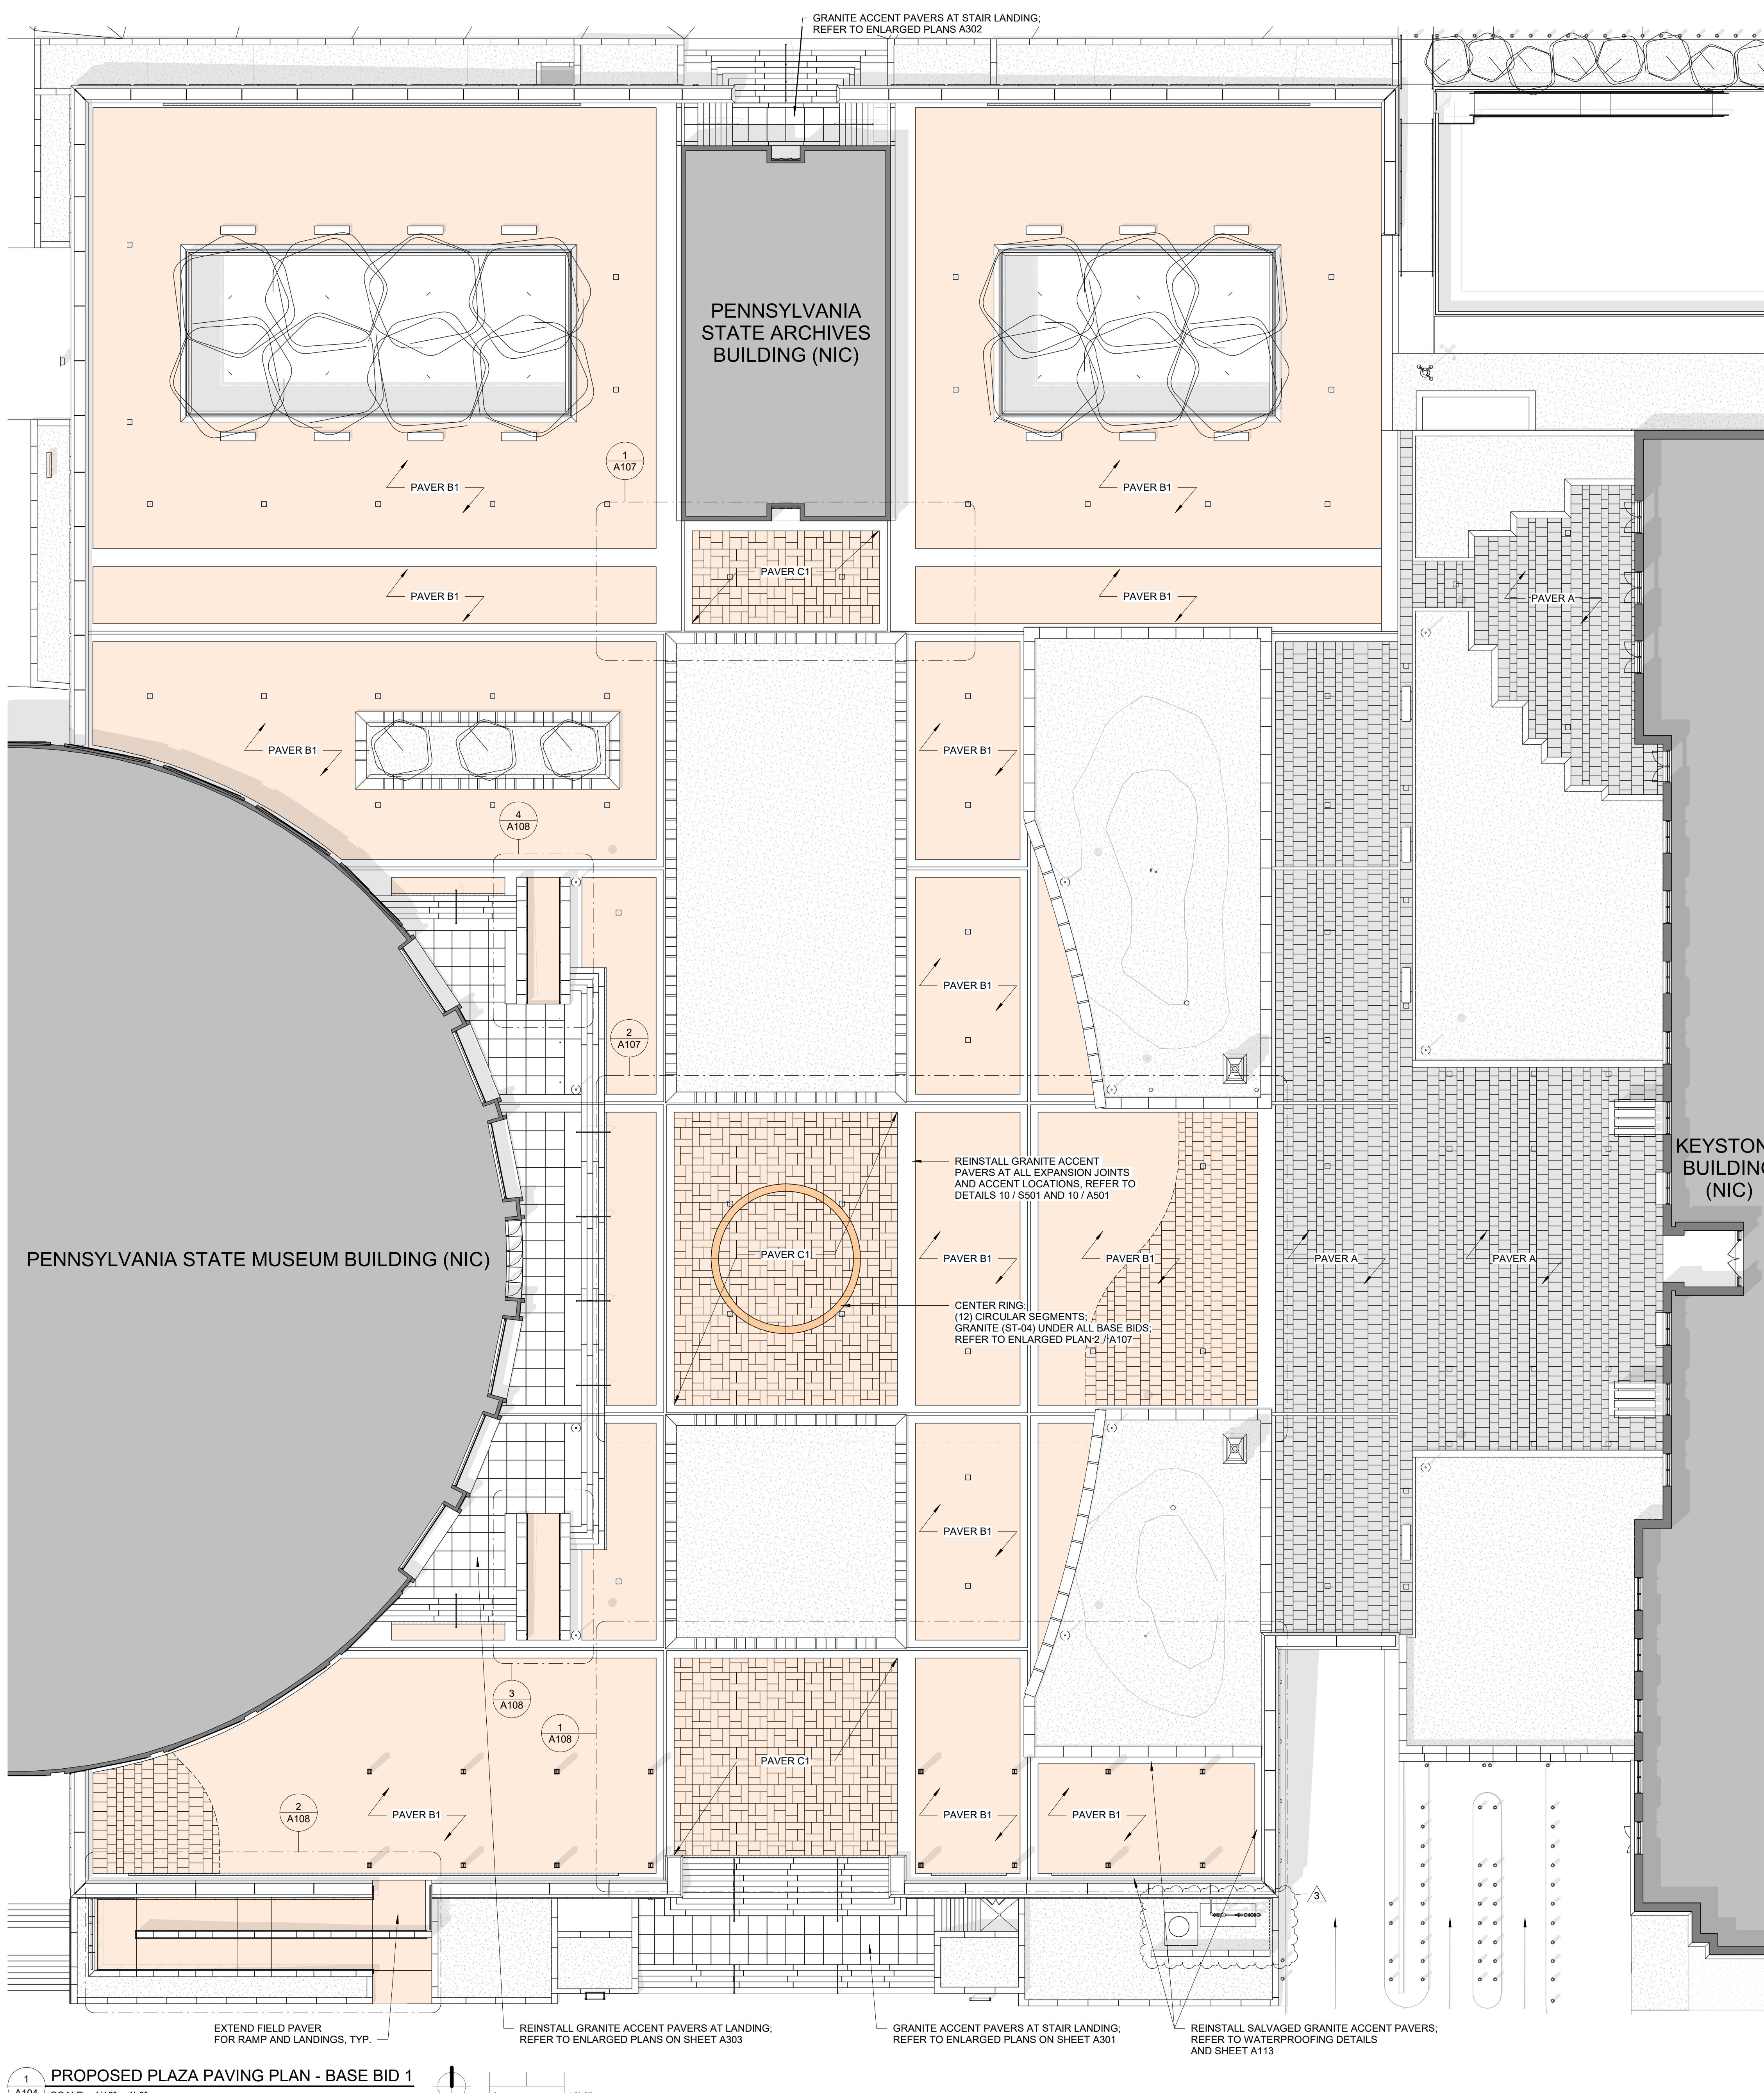

PLAN KEY - BASE BID 1


GENERAL NOTE:
PAVER DIMS. NOTED BELOW ARE NOMINAL. JOINT WIDTH AND FIELD VERIFIED CONDITIONS
SHOULD BE REFLECTED IN FINAL PAVER DIMS. REFER TO SPECIFICATIONS FOR JOINT WIDTH AT
BOTH GRANITE AND CAST STONE PAVERS.

A GRANITE FIELD PAVER (REUSED) - TYPICAL PATTERN

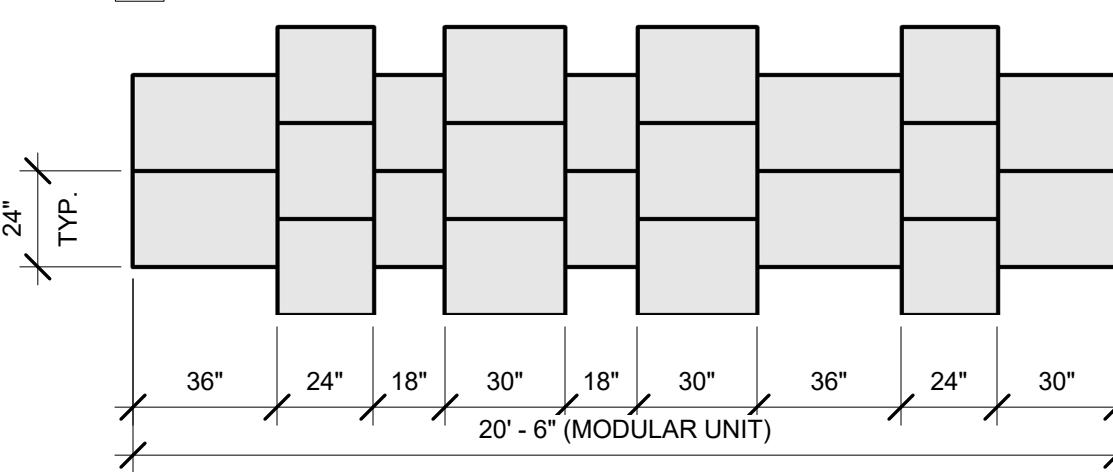


NOTE:
REINSTALL EXISTING GRANITE FIELD PAVERS AS INDICATED ON PLAN;
MAINTAIN EXISTING PATTERN

B1 CAST STONE FIELD PAVER (NEW) - TYPICAL PATTERN

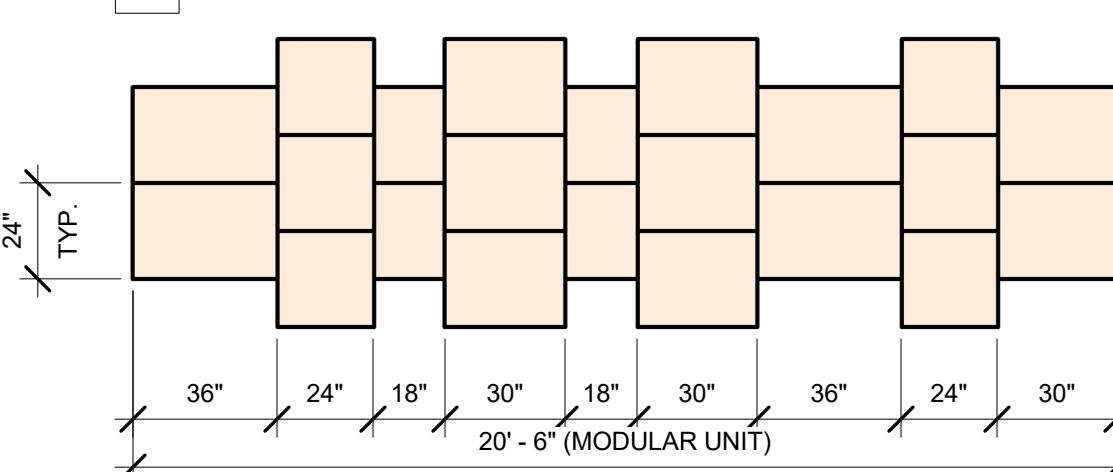

NOTE:
INSTALL CAST STONE FIELD PAVERS AS INDICATED ON PLAN;
MATCH PATTERN OF REINSTALLED PAVERS

C1 CAST STONE FIELD PAVER (NEW) - TYPICAL PATTERN

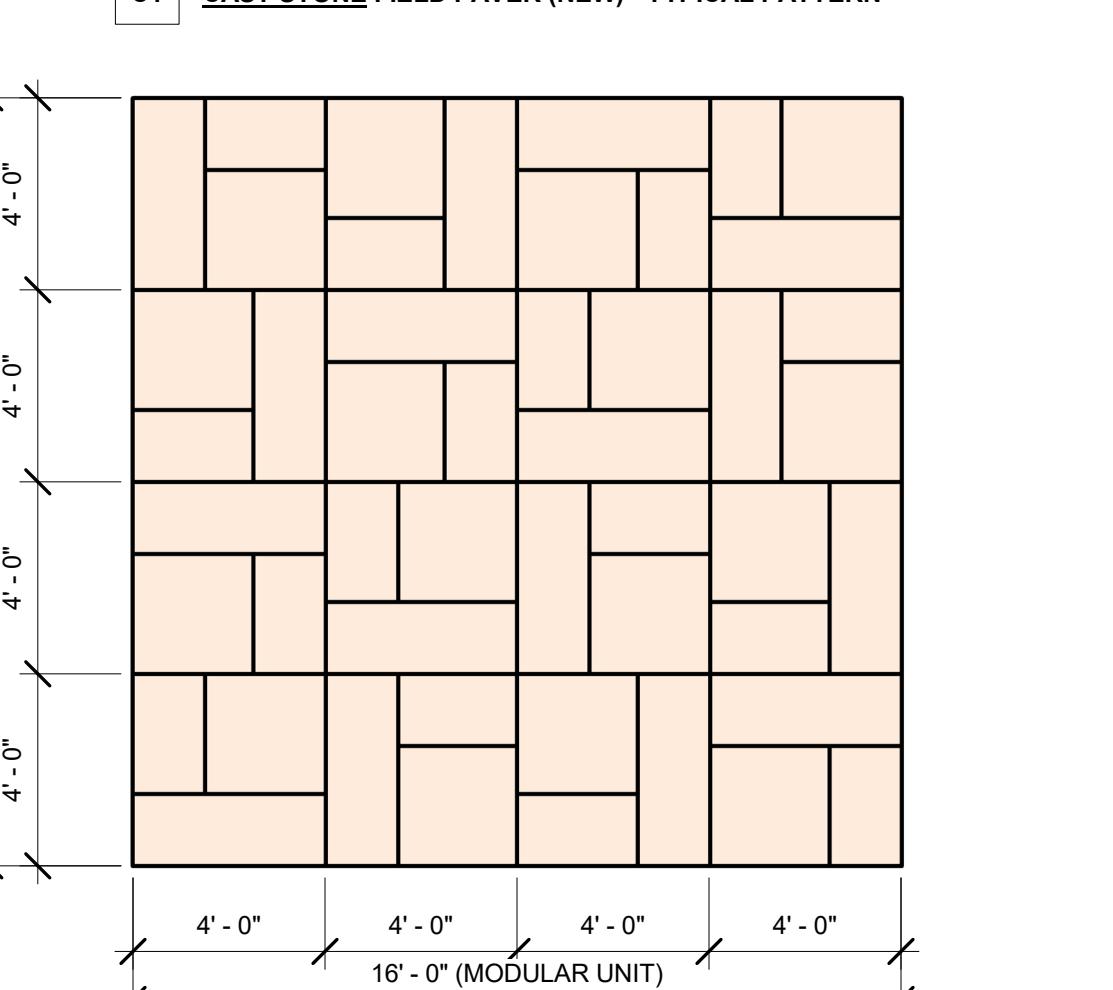

NOTE:
INSTALL CAST STONE FIELD PAVERS ALONG ARCHIVE TOWER / CAPITOL AXIS;
PATTERN SIMILAR TO ORIGINAL 1960 DESIGN

PAVER FINISH SCHEDULE

TAG	PRODUCT
A	EXISTING GRANITE TO REMAIN
B1	CAST STONE, MATCH ARCHITECT'S CONTROL SAMPLE
B2	POLYCOR, GRANITE, TITANIUM PEARL, FLAMED FINISH
C1	CAST STONE, MATCH ARCHITECT'S CONTROL SAMPLE
C2	POLYCOR, GRANITE, TITANIUM PEARL, FLAMED FINISH
ST-04	BLACK GRANITE, FLAMED FINISH, MATCH ARCHITECT'S CONTROL SAMPLE

AS-BUILT REVISIONS

CDA

CHRIS DAWSON ARCHITECT

300 NORTH 2ND STREET, SUITE 701, HARRISBURG, PA 17101

COMMONWEALTH OF PENNSYLVANIA

DEPARTMENT OF GENERAL SERVICES

PROJECT No. **PGC 042 07 PHASE 1**


800 340-0711 PHASE 1


**PLAZA PAVER REPAIR / REPLACEMENT
PA STATE MUSEUM,
THE CAPITOL COMPLEX
HARRISBURG, DAUPHIN COUNTY, PA**


PLAZA PAVING PLAN - BASE BID 1

BY	DATE 07.29.25	DRAWING NO. A104
ED BY	SCALE PER DWG	

DRAWING SET IS INTENDED FOR COLOR PRINTING

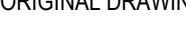
VERIFY SCALE	PLAZA PAVER REPAIR / REPLACEMENT PA STATE MUSEUM, THE CAPITOL COMPLEX HARRISBURG, DAUPHIN COUNTY, PA		
BAR IS ONE (1) INCH LONG ON ORIGINAL DRAWING: 0  1	PLAZA PAVING PLAN - BASE BID 1		
IF BAR IS NOT ONE (1) INCH LONG, ADJUST SCALE ACCORDINGLY	DRAWN BY JB	DATE 07.29.25	DRAWING NO.
CONTRACTOR SHALL FIELD VERIFY ALL DIMENSIONS. VARIANCE FROM CONTRACT DOCUMENTS NOT PERMITTED WITHOUT PROFESSIONAL & BUREAU OF CONSTRUCTION APPROVAL	CHECKED BY WE	SCALE PER DWG	A104

 

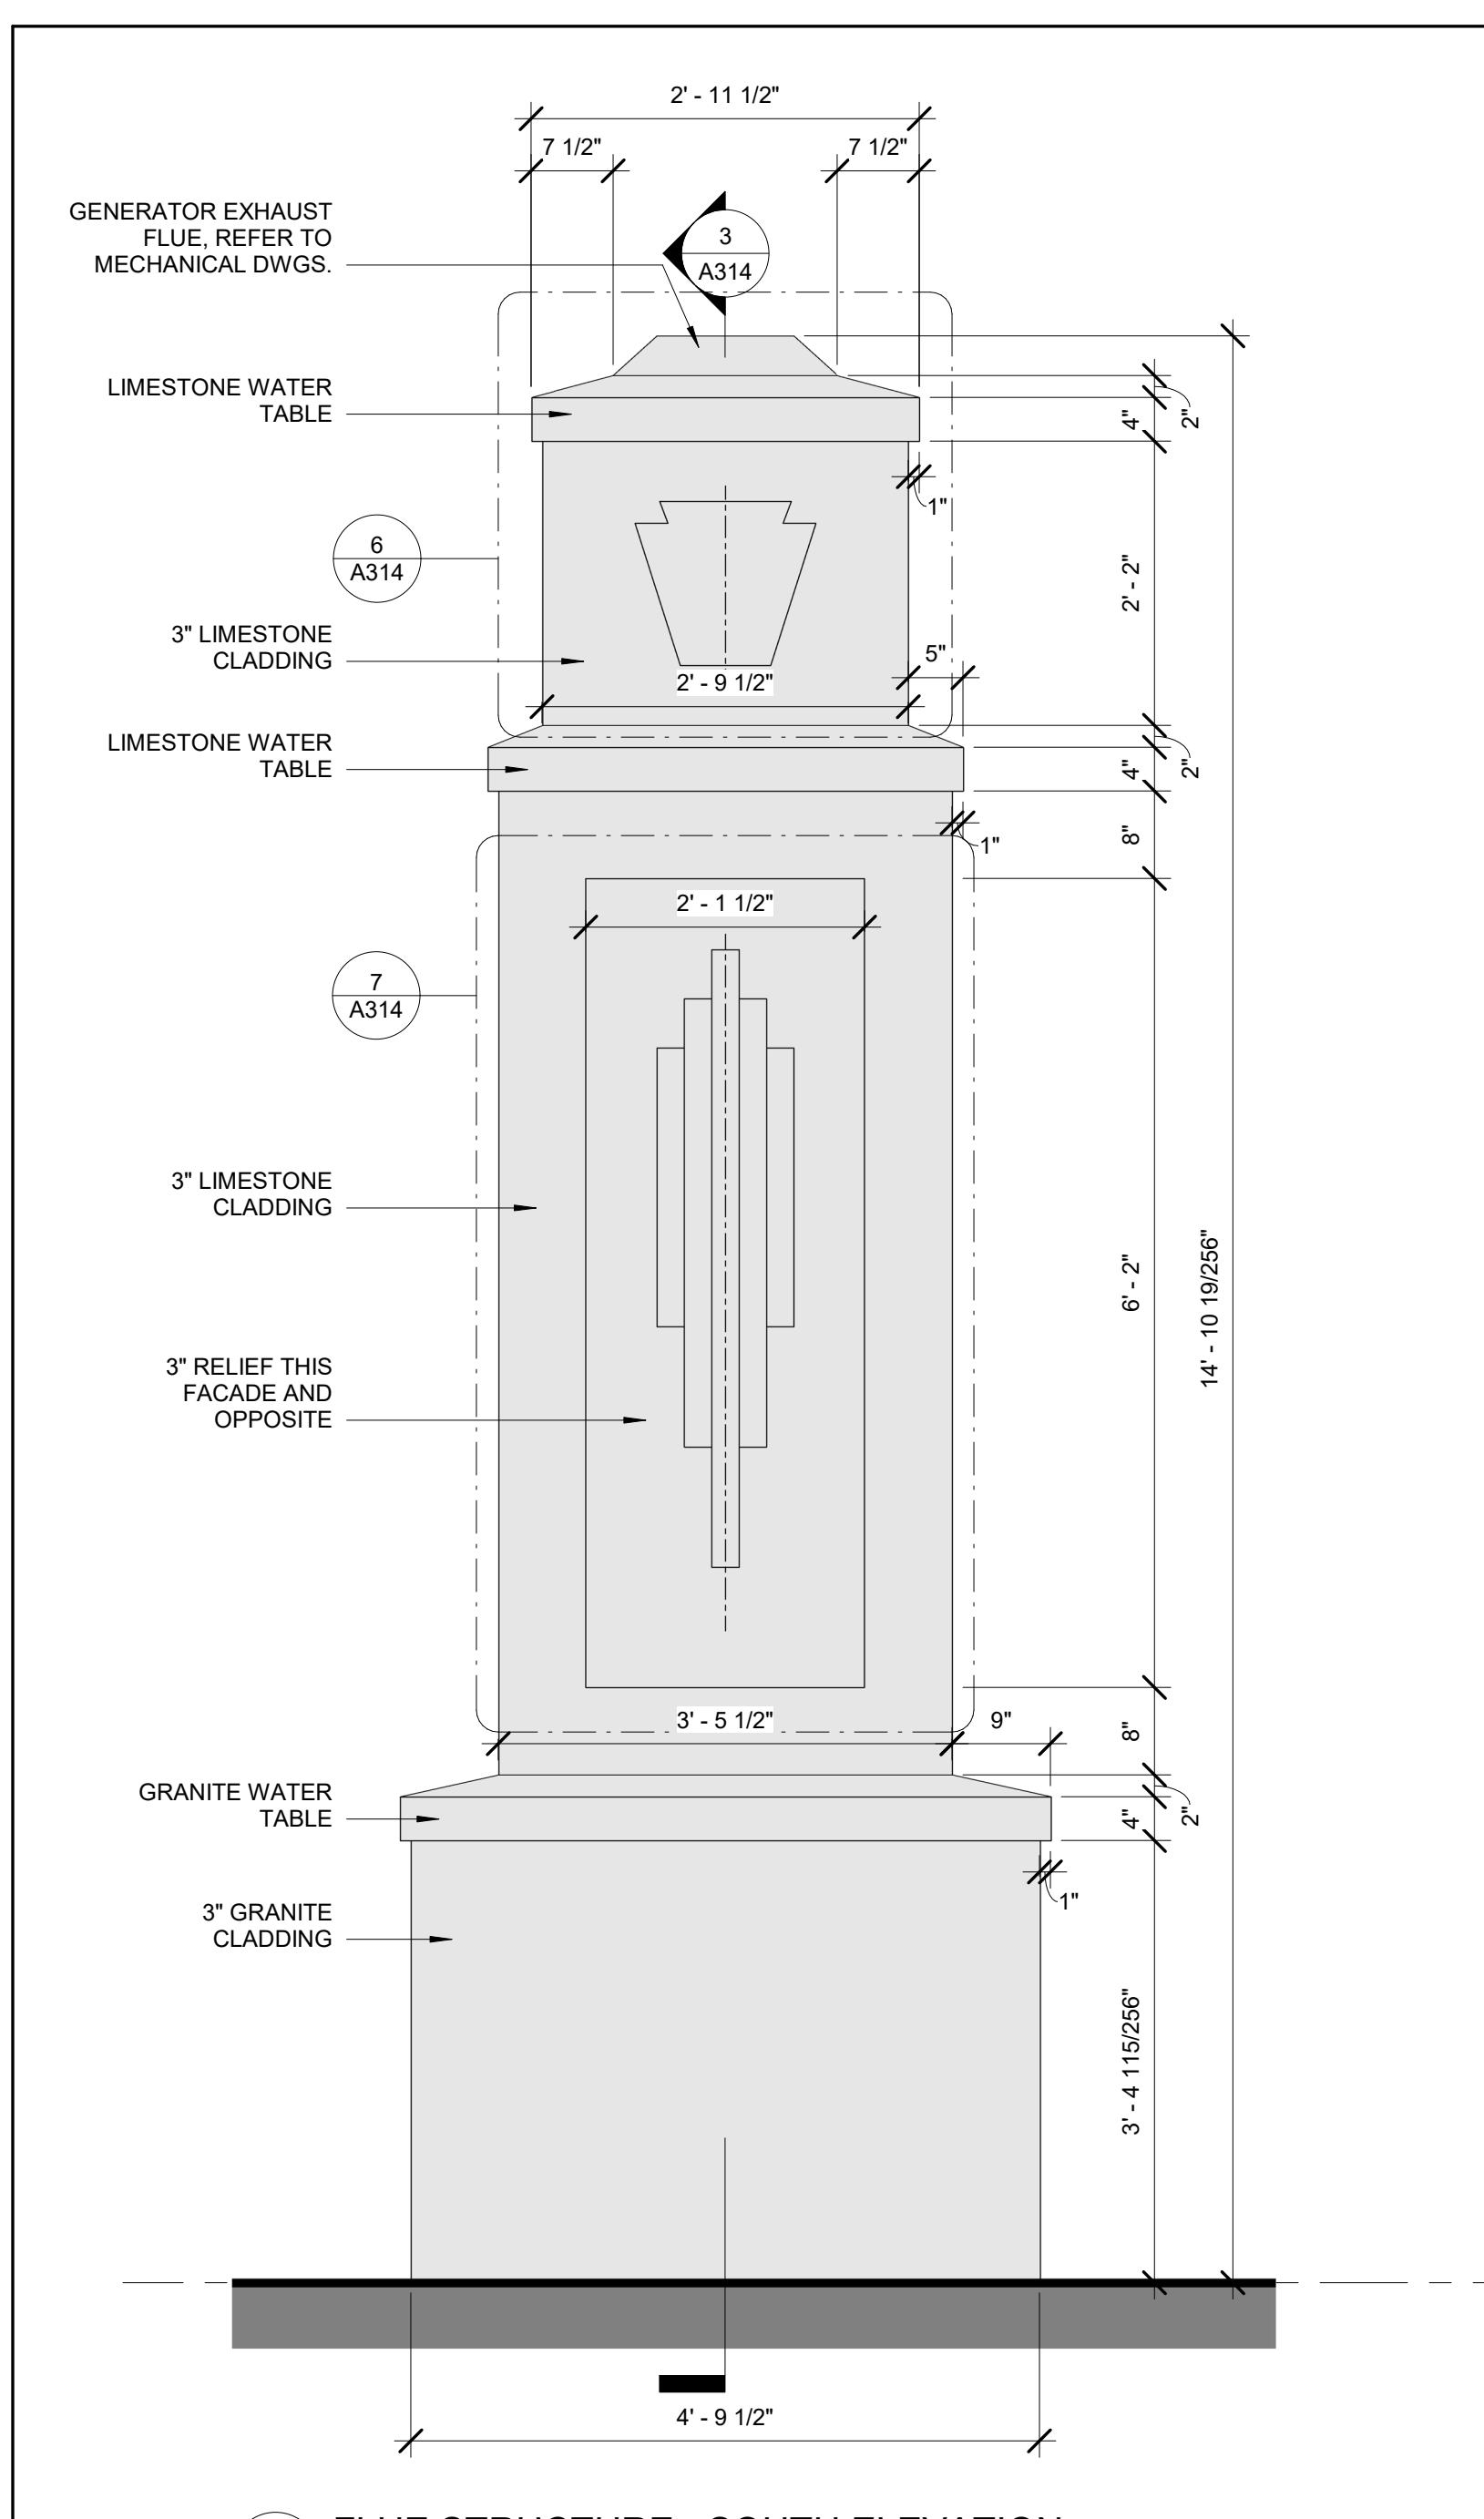


1 FLUE STRUCTURE - SOUTH ELEVATION
A314 SCALE: 3/4" = 1'-0"

NOTE: DRAWING TO MATCH DESIGN OF SIMILAR FLUE STRUCTURE PER PROJECT C-0948-0094. COORDINATE FINAL CONSTRUCTION DETAILS W/ DGS BUREAU OF CONSTRUCTION

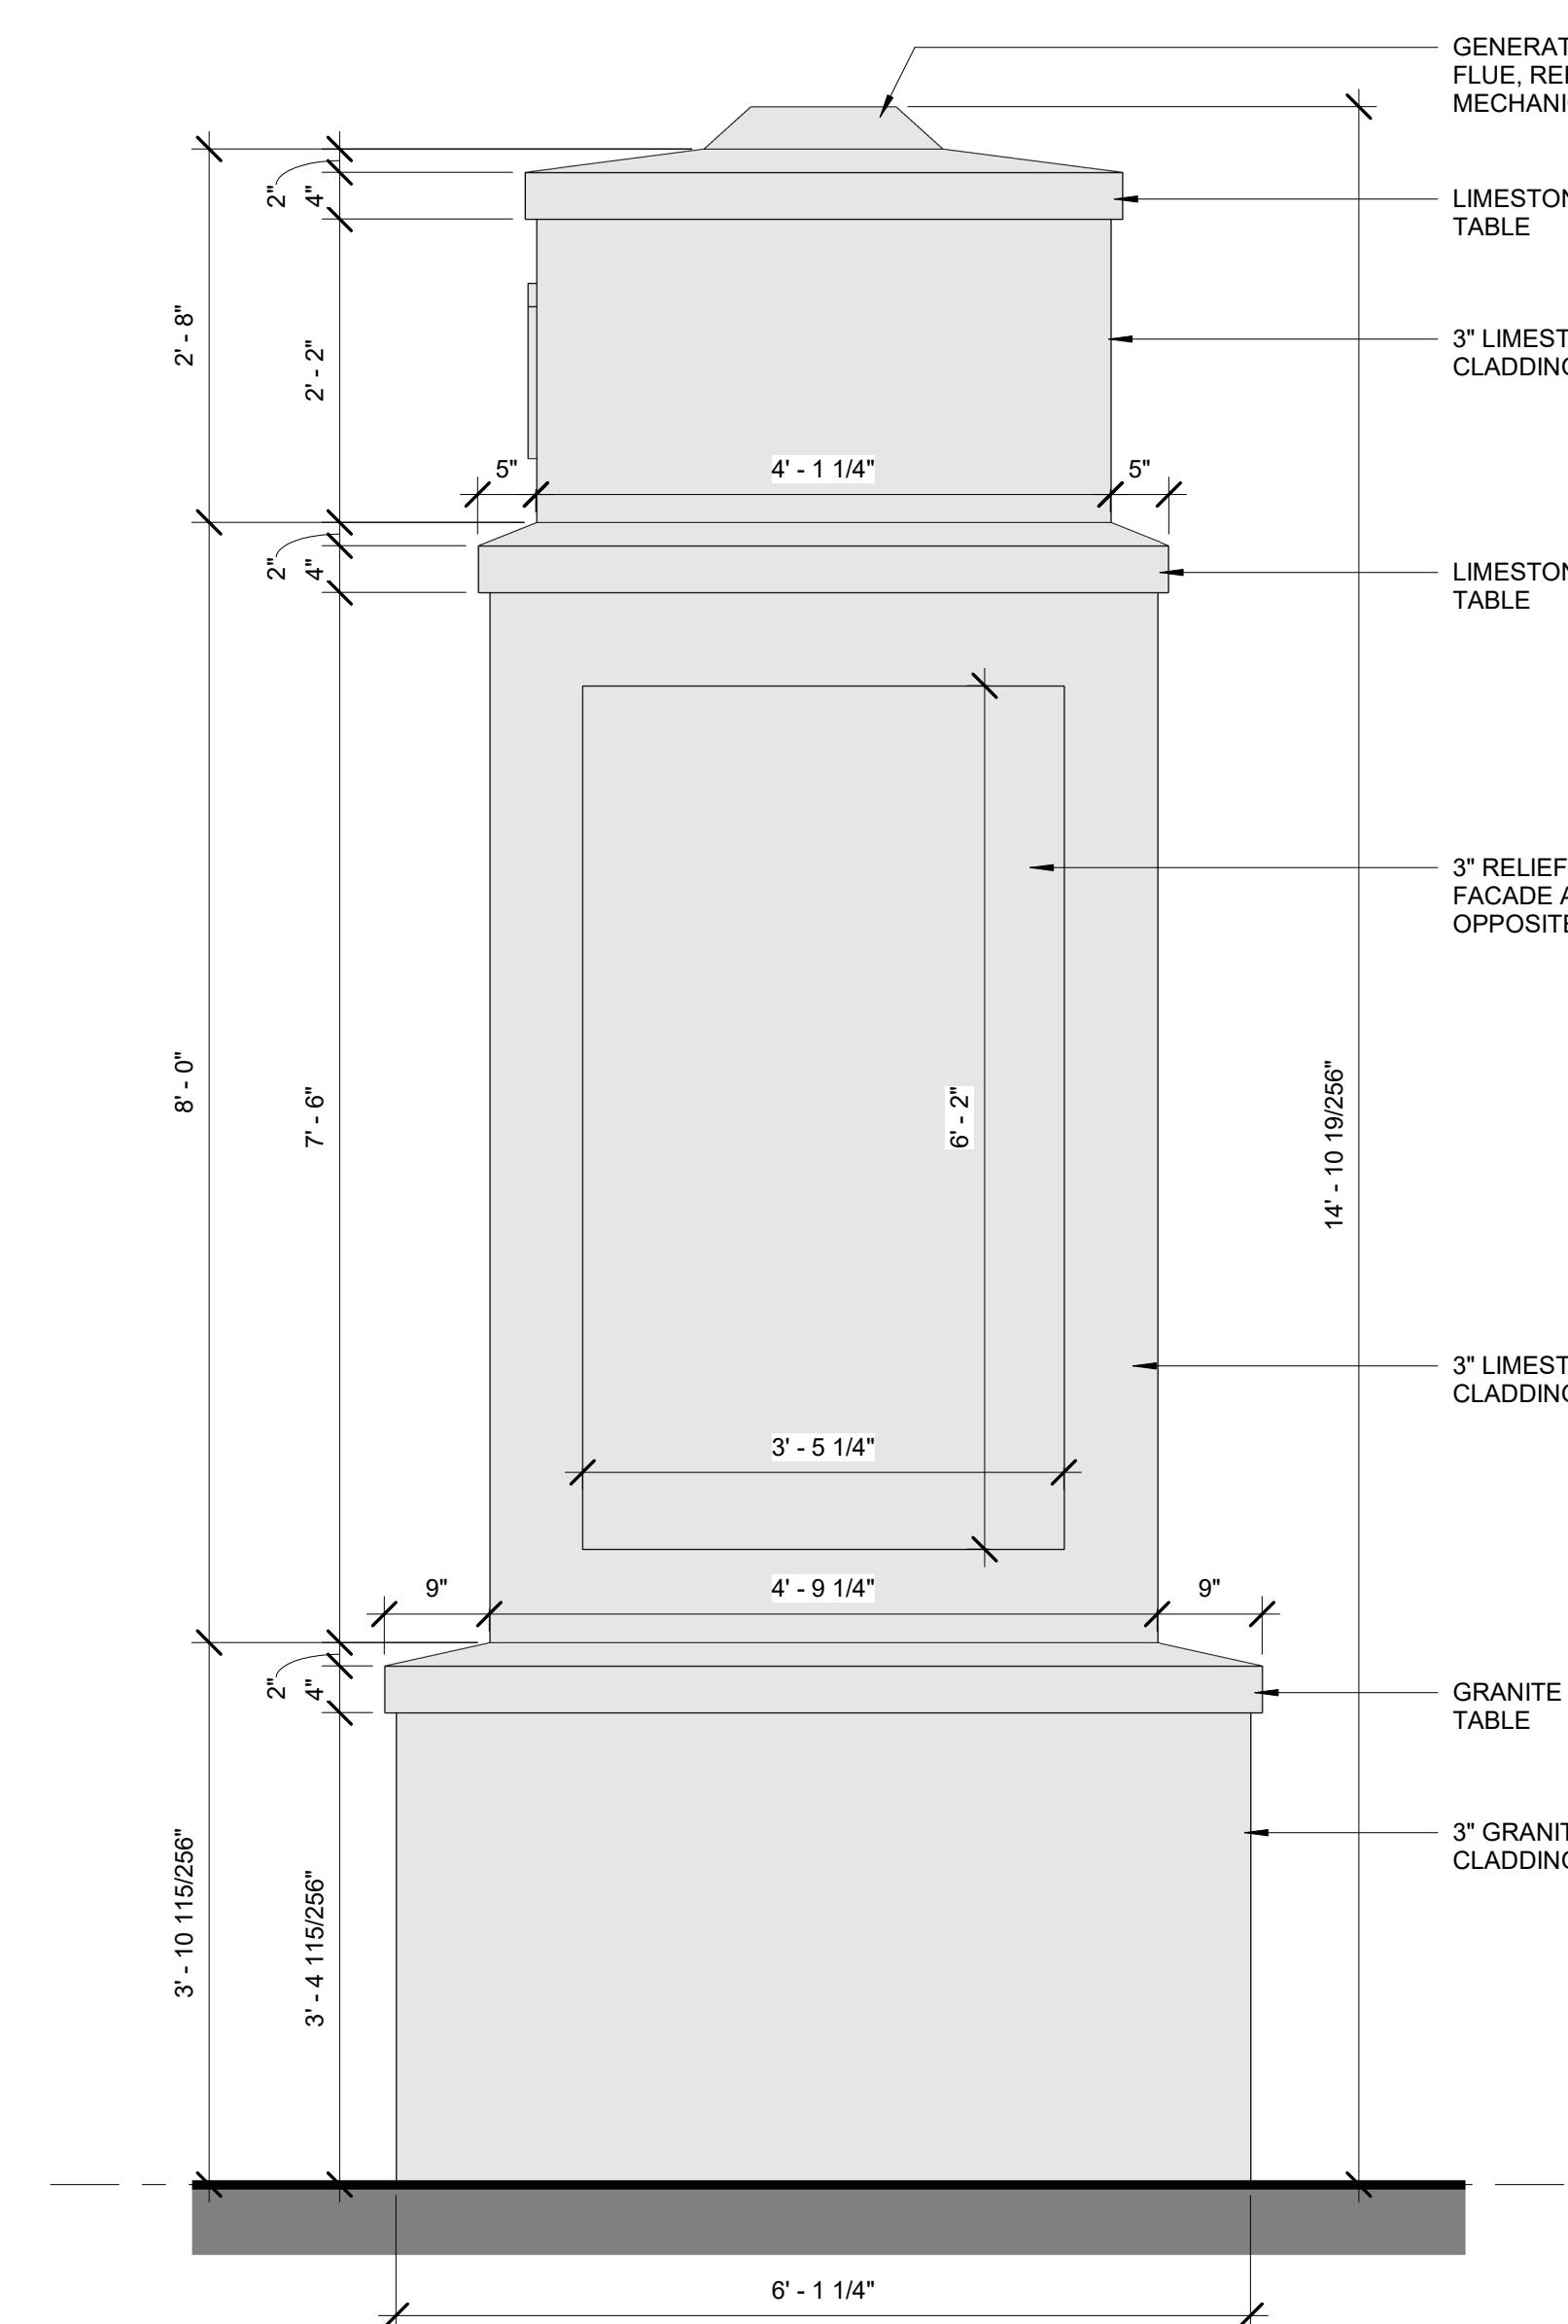


2 FLUE STRUCTURE - EAST ELEVATION

A314 SCALE: 3/4" = 1'-0"


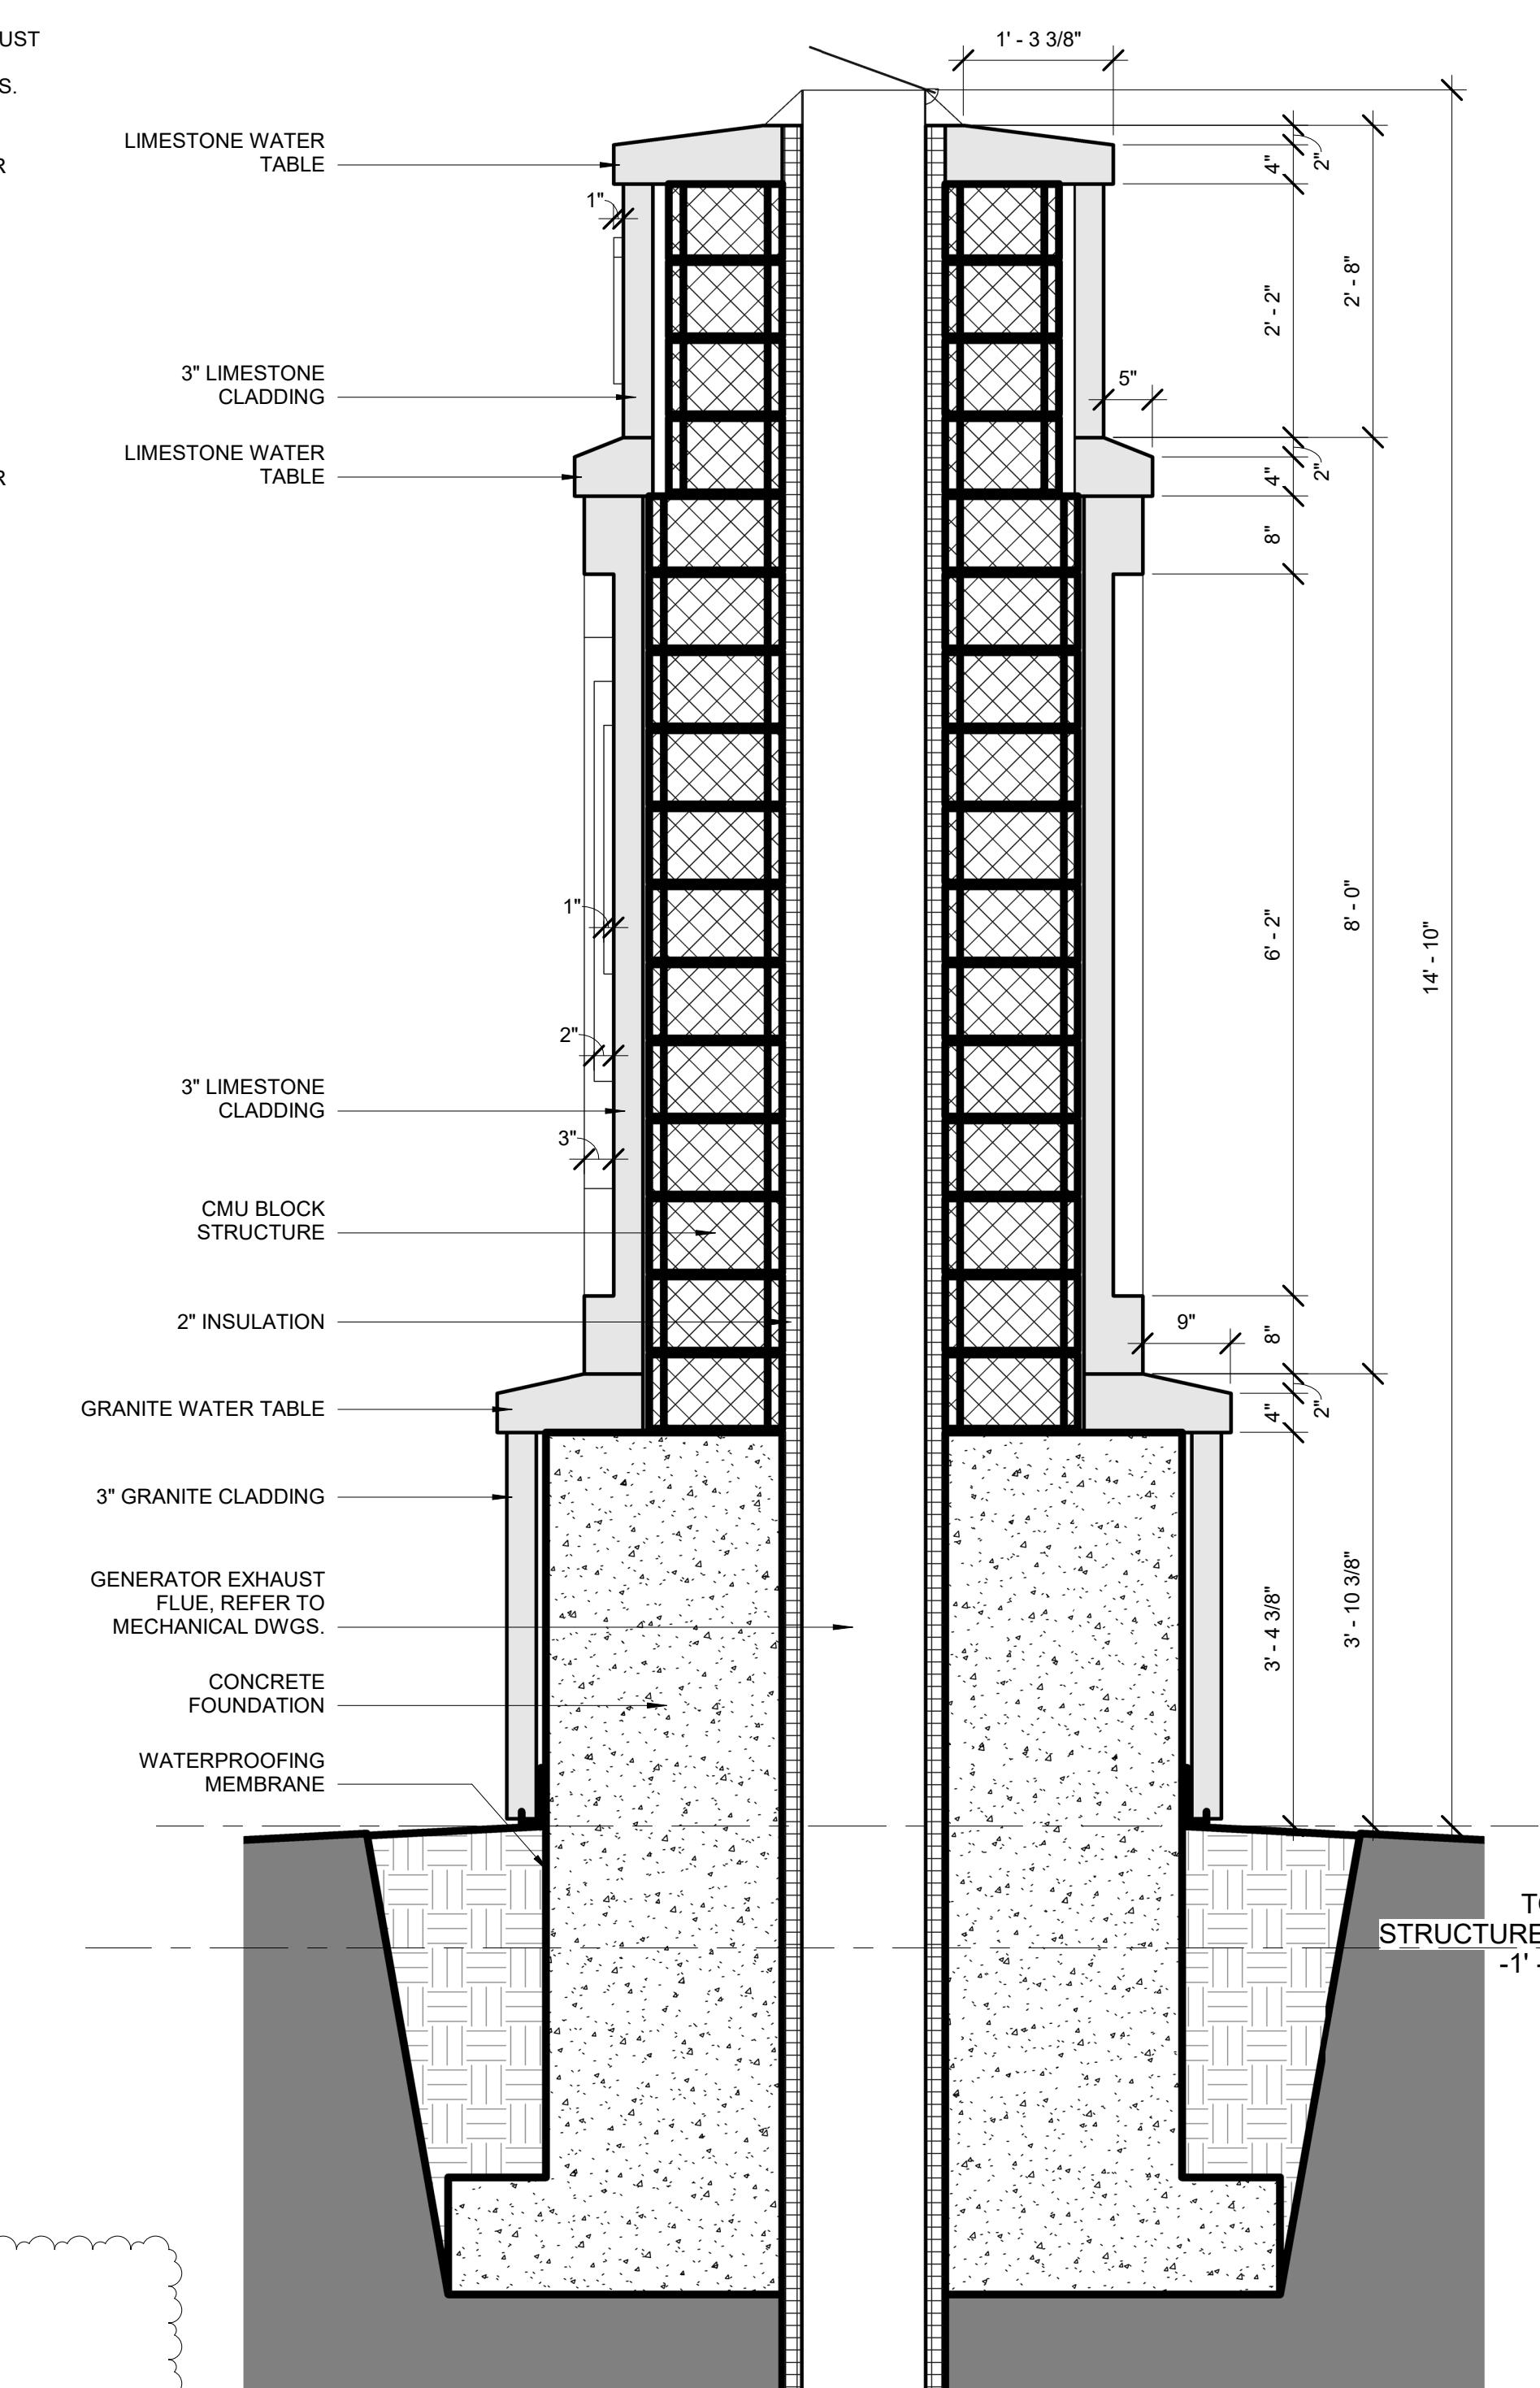


3 FLUE STRUCTURE - SECTION A
A314 SCALE: 3/4" = 1'-0"

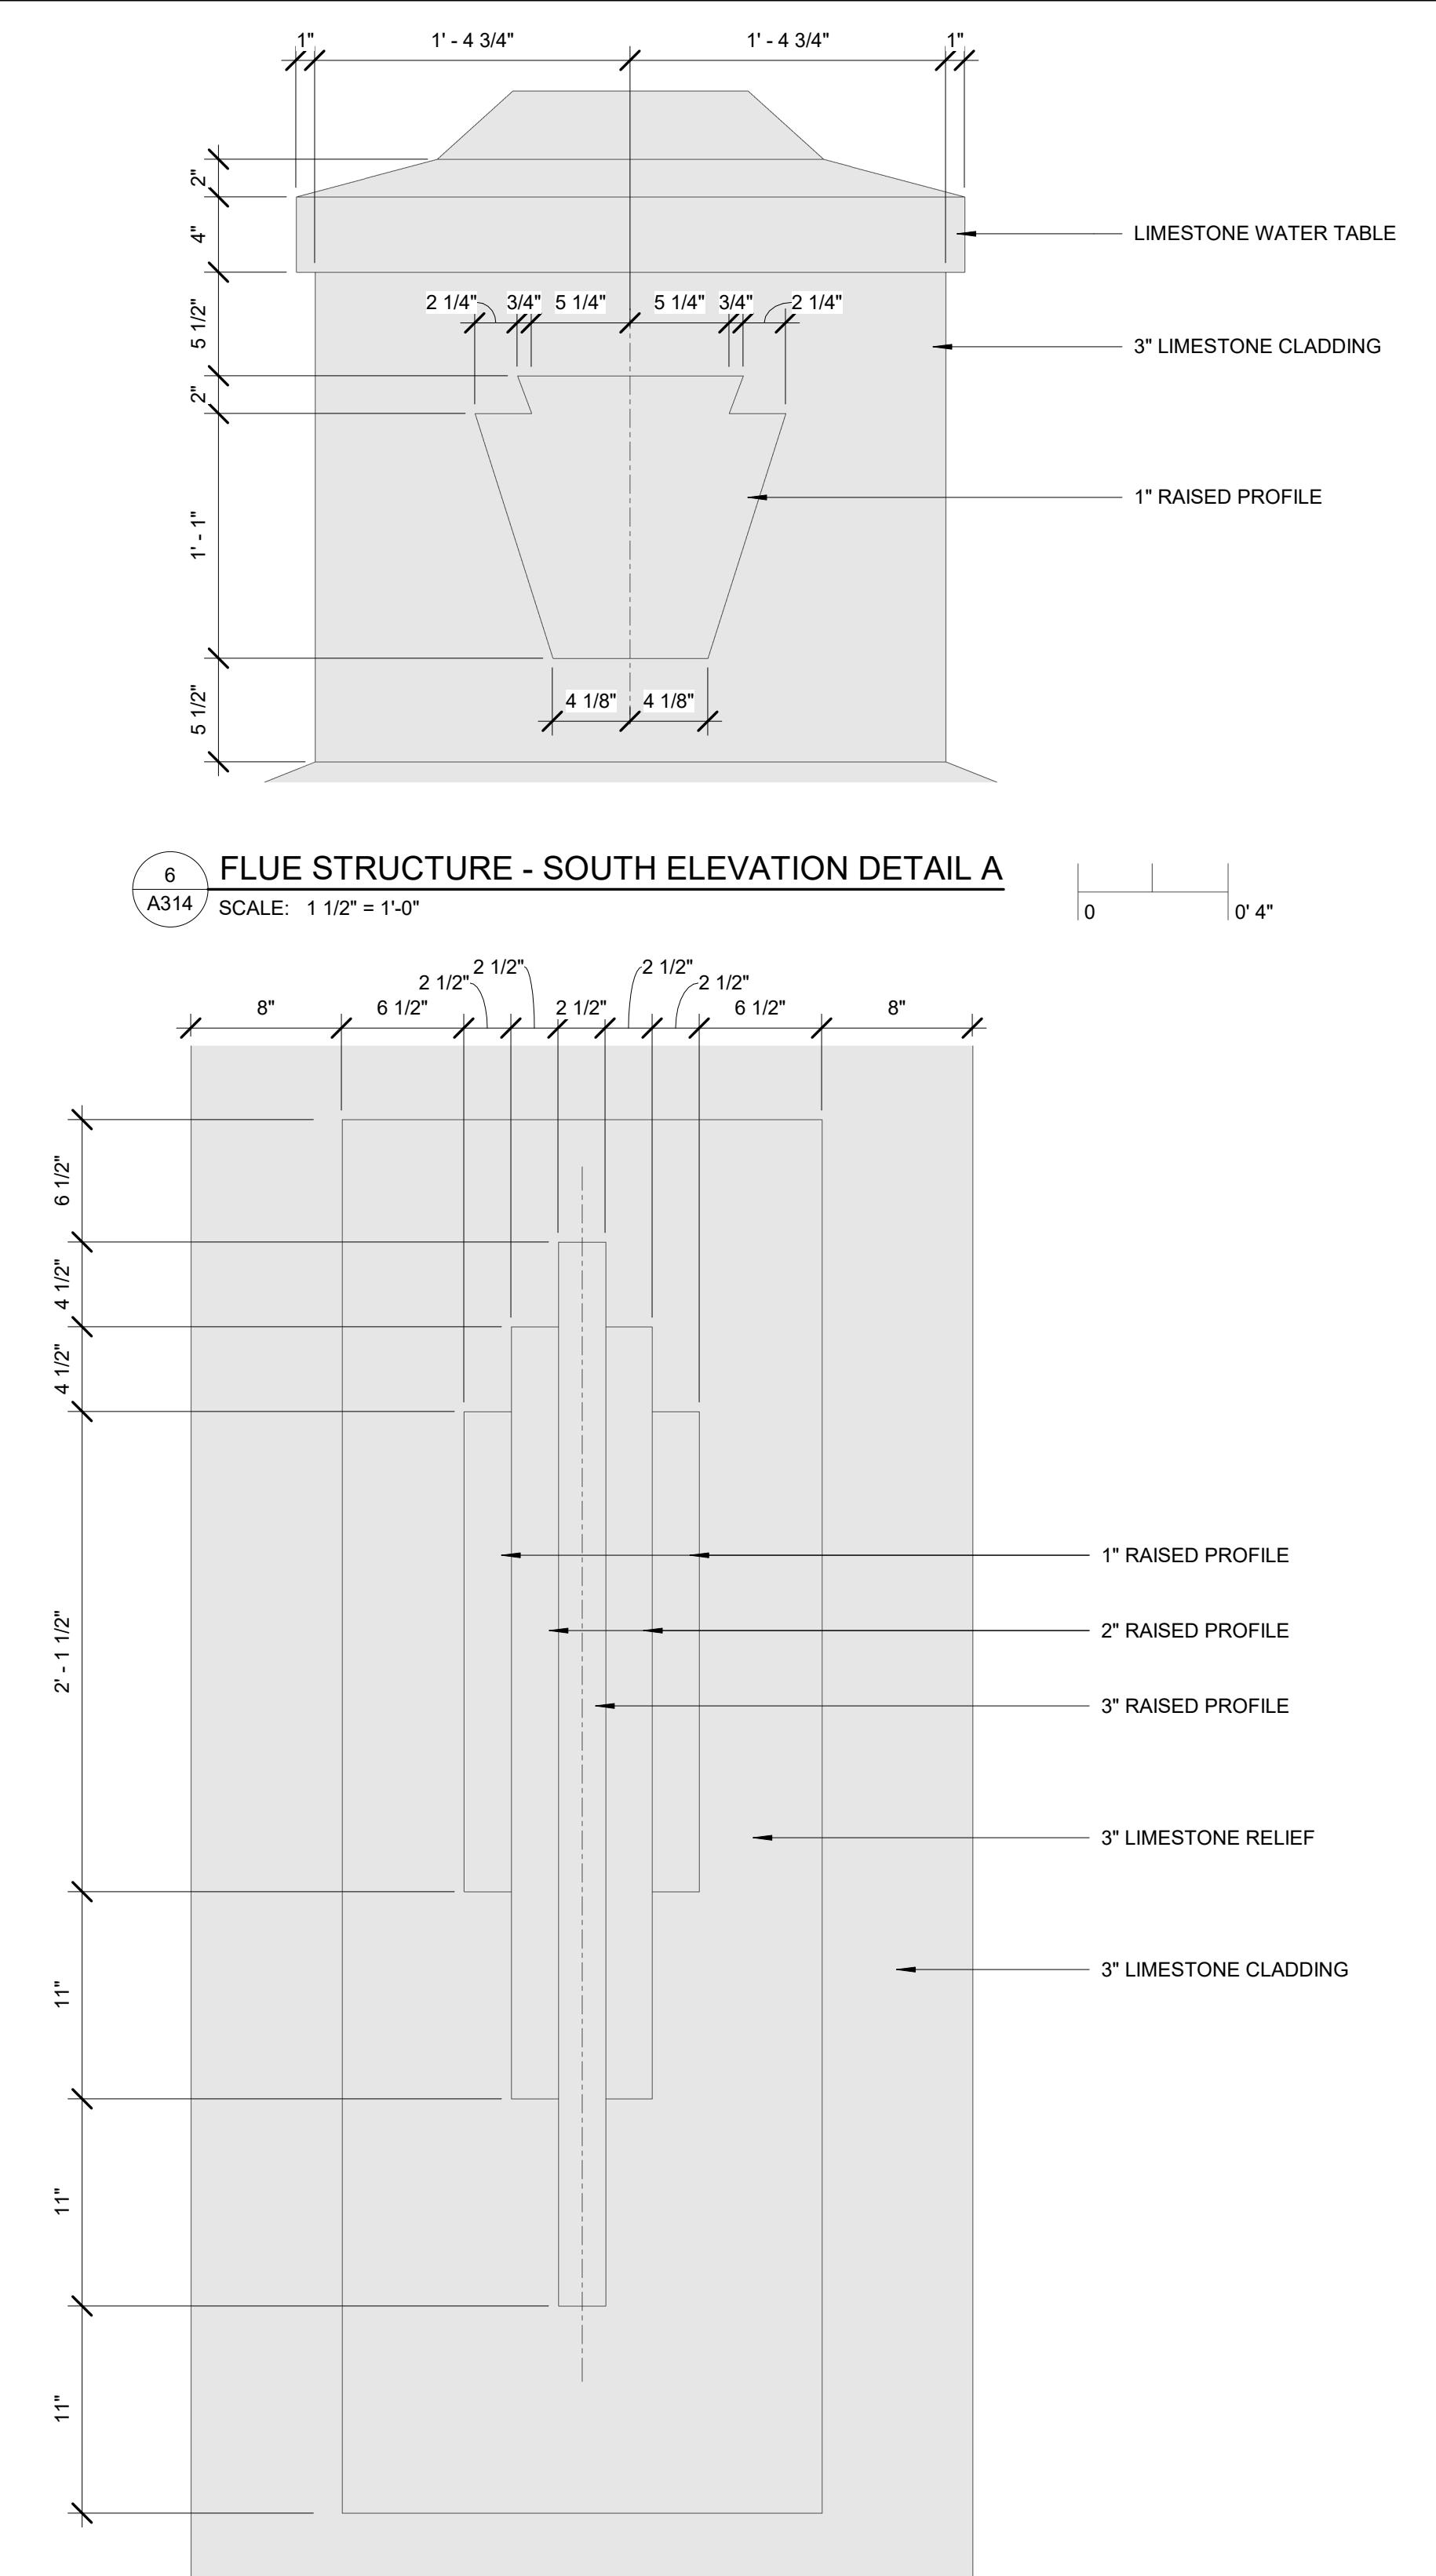

7 FLUE STRUCTURE - SOUTH ELEVATION DETAIL B

A314 SCALE: 1 1/2" = 1'-0"

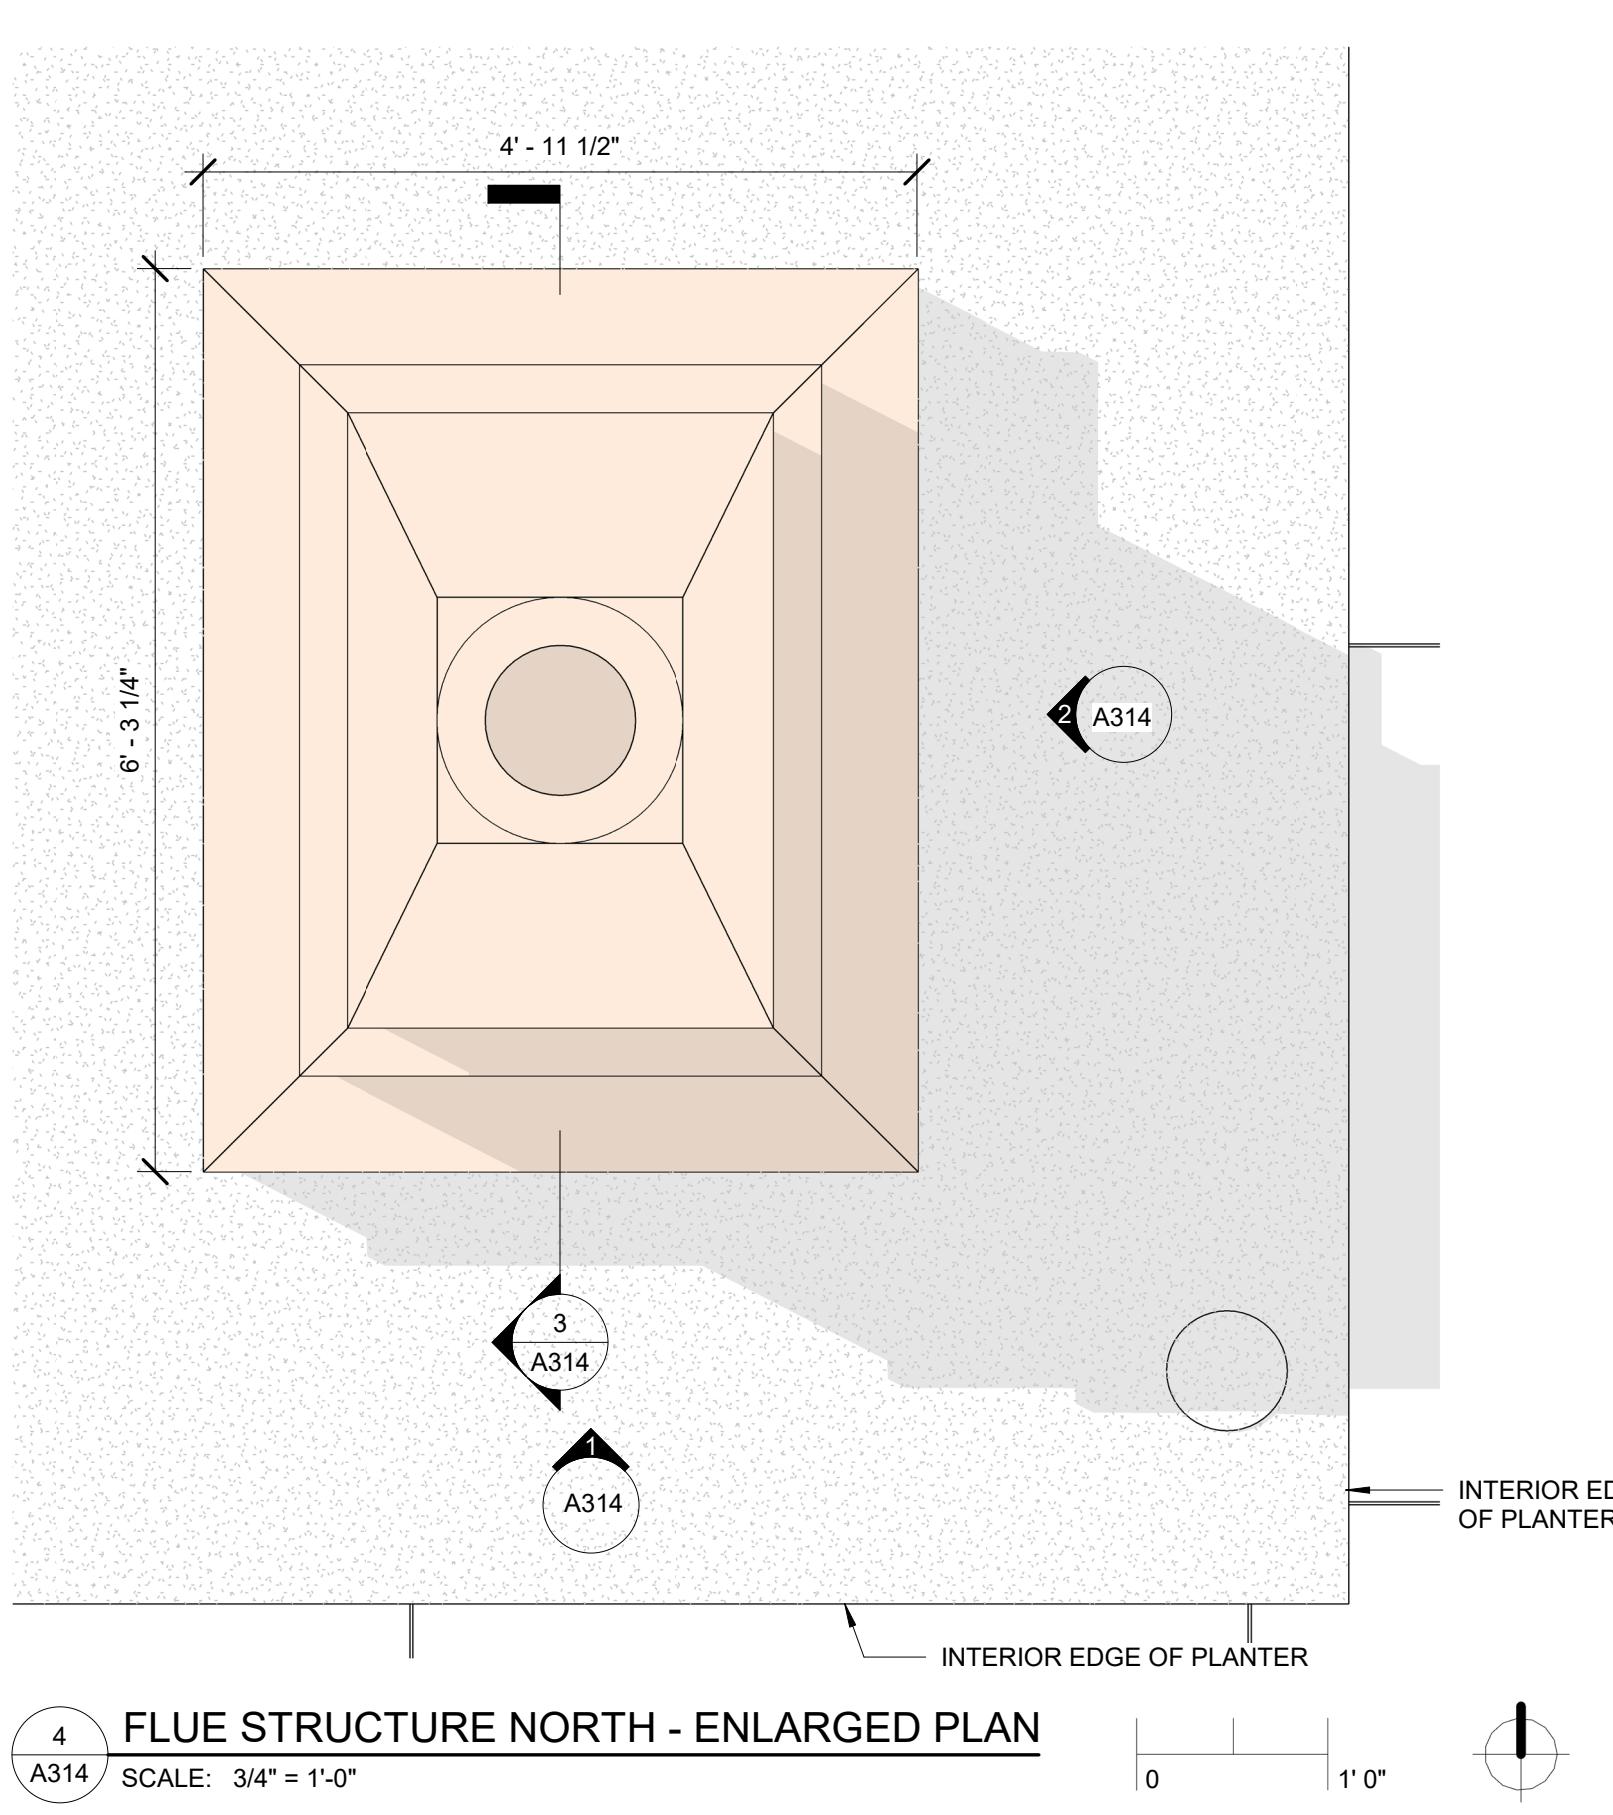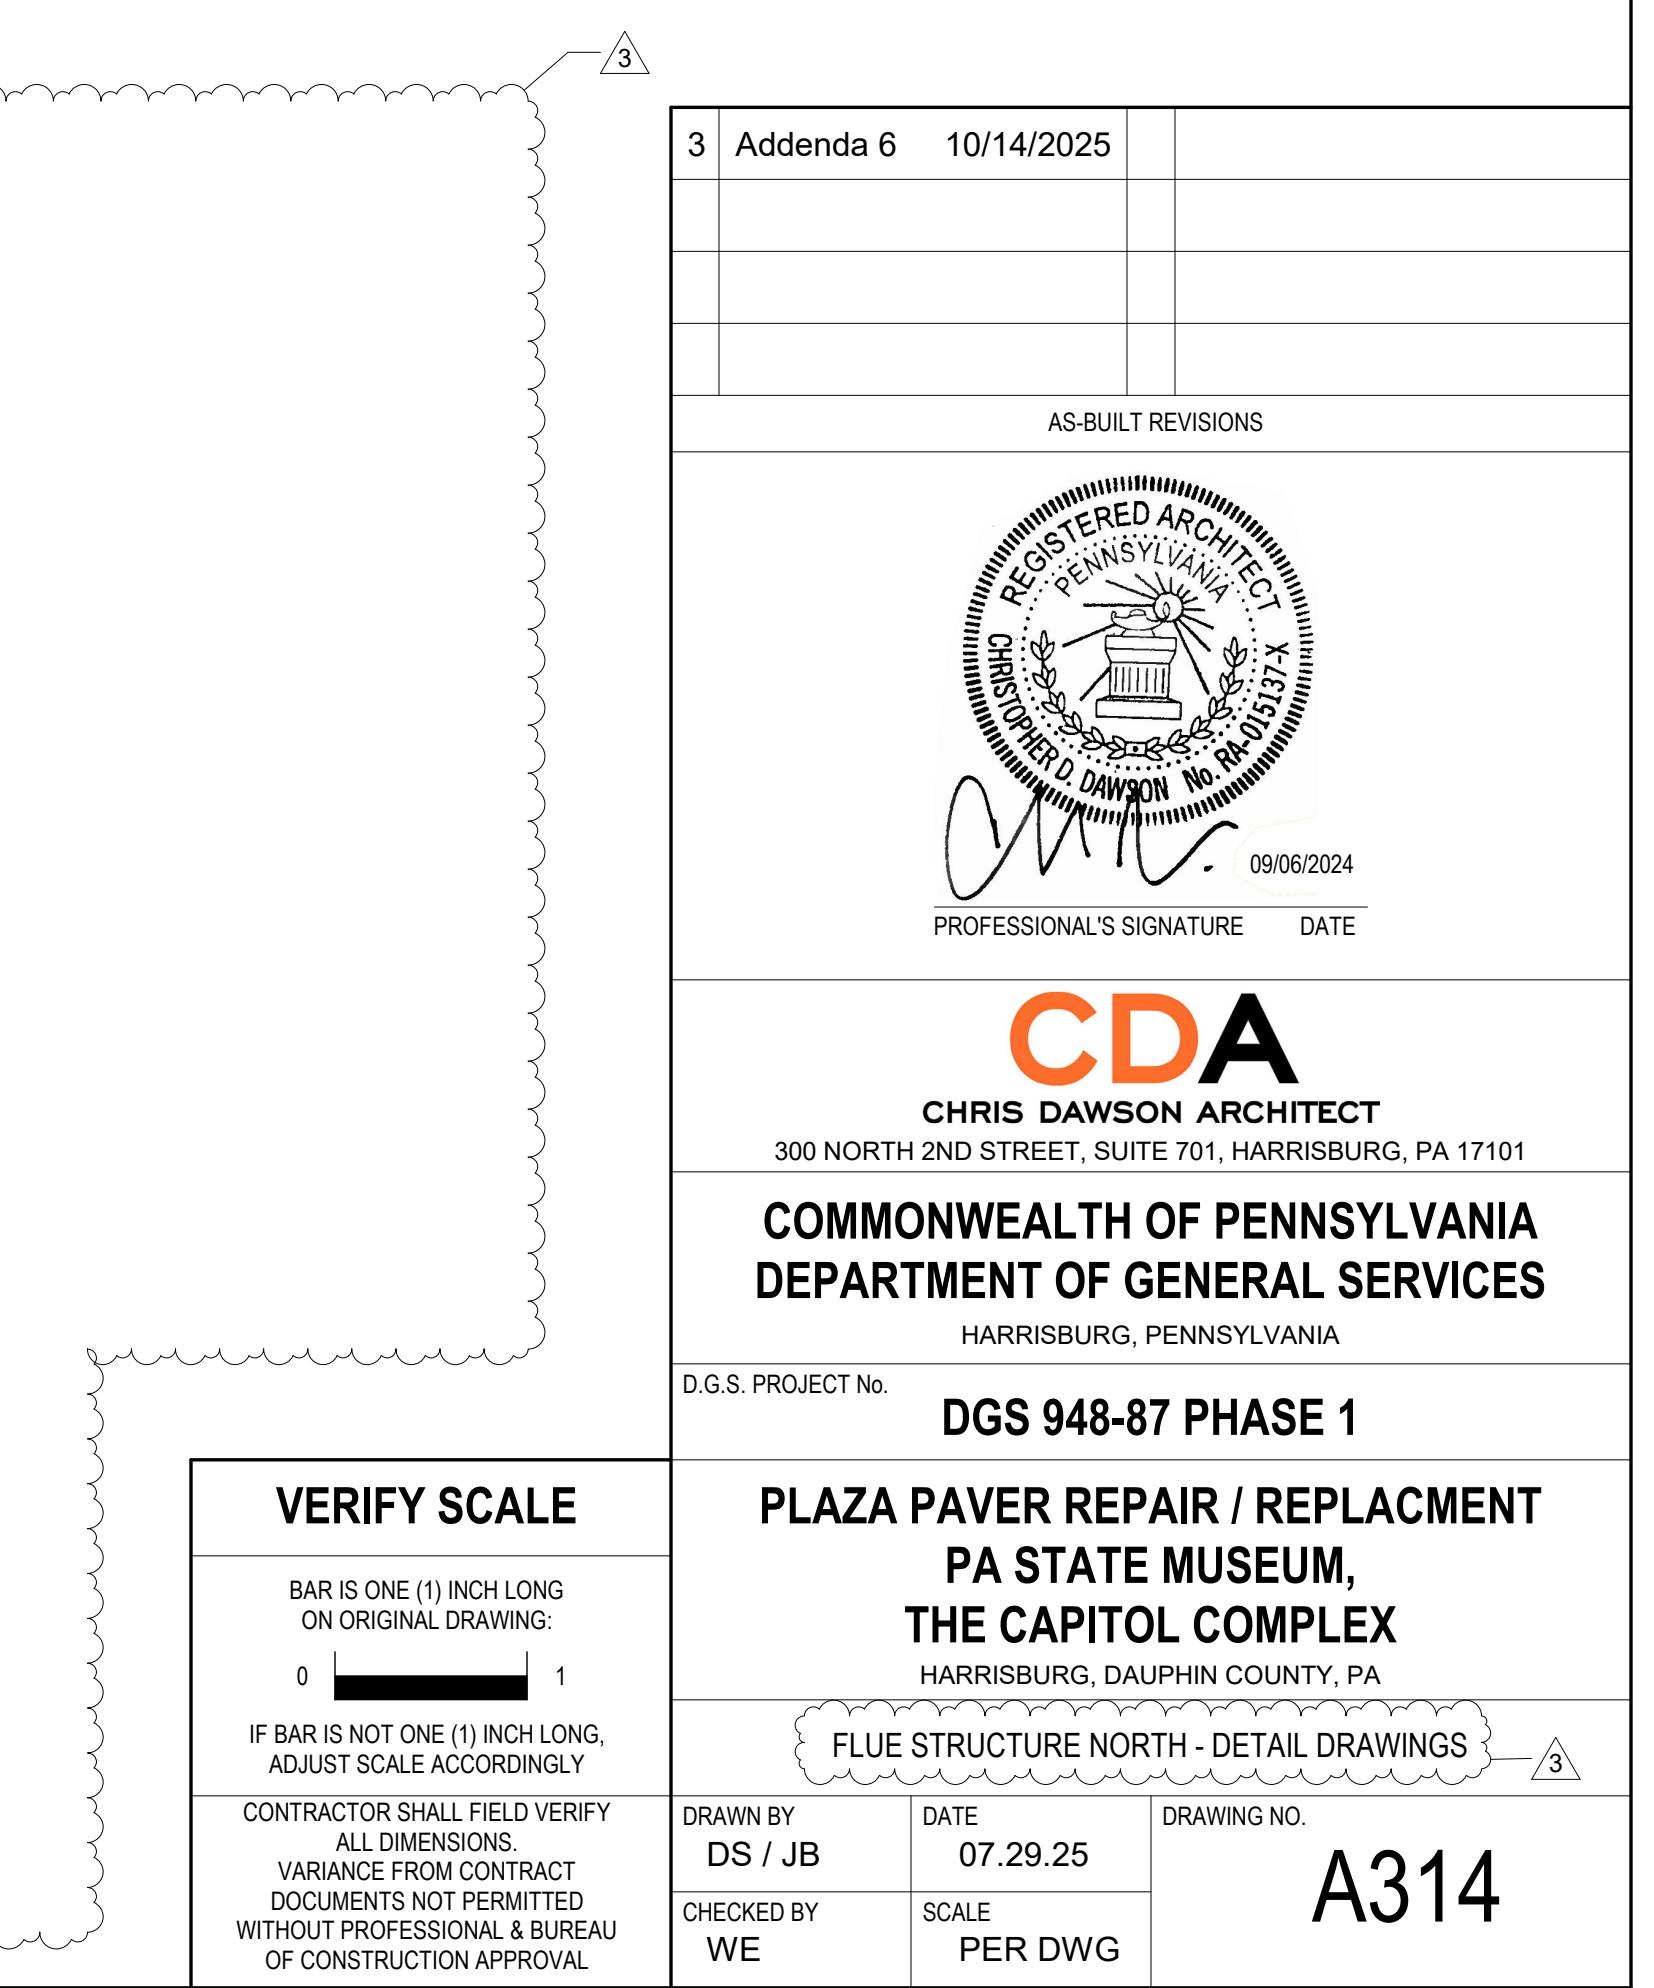

4 FLUE STRUCTURE NORTH - ENLARGED PLAN
A314 SCALE: 3/4" = 1'-0"

CDA
CHRIS DAWSON ARCHITECT

300 NORTH 2ND STREET, SUITE 701, HARRISBURG, PA 17101

COMMONWEALTH OF PENNSYLVANIA
DEPARTMENT OF GENERAL SERVICES

HARRISBURG, PENNSYLVANIA

DGS 946-87 PHASE I

PLAZA PAVER REPAIR / REPLACEMENT PA STATE MUSEUM

PA STATE MUSEUM, THE CAPITOL COMPLEX

THE CAPITOL COMPLEX

HARRISBURG, DAUPHIN COUNTY, PA





FLUE STRUCTURE NORTH - DETAIL DRAWINGS

BY DATE DRAWING NO.
/ JB 07.29.25 A214

SCALE
PER DWG

DRAWING SET IS INTENDED FOR COLOR PRINT

Digitized by srujanika@gmail.com

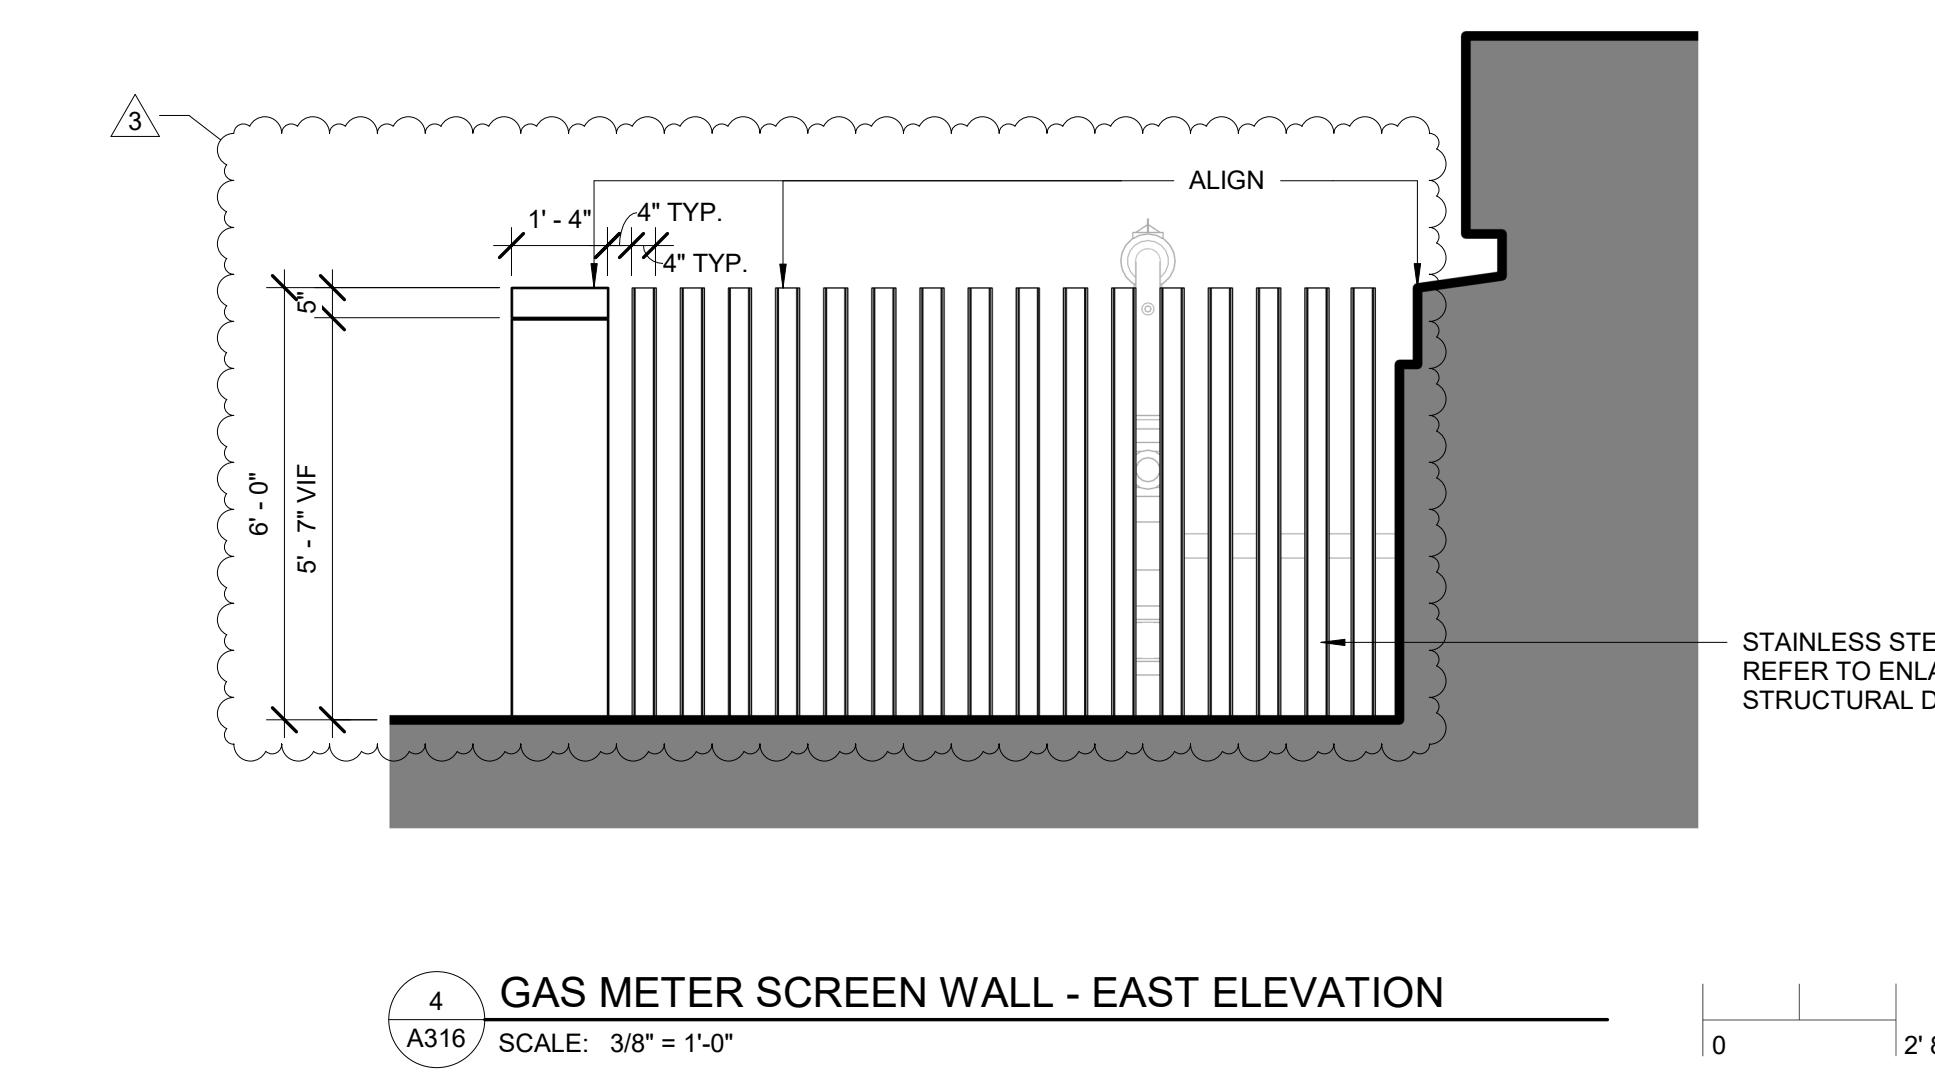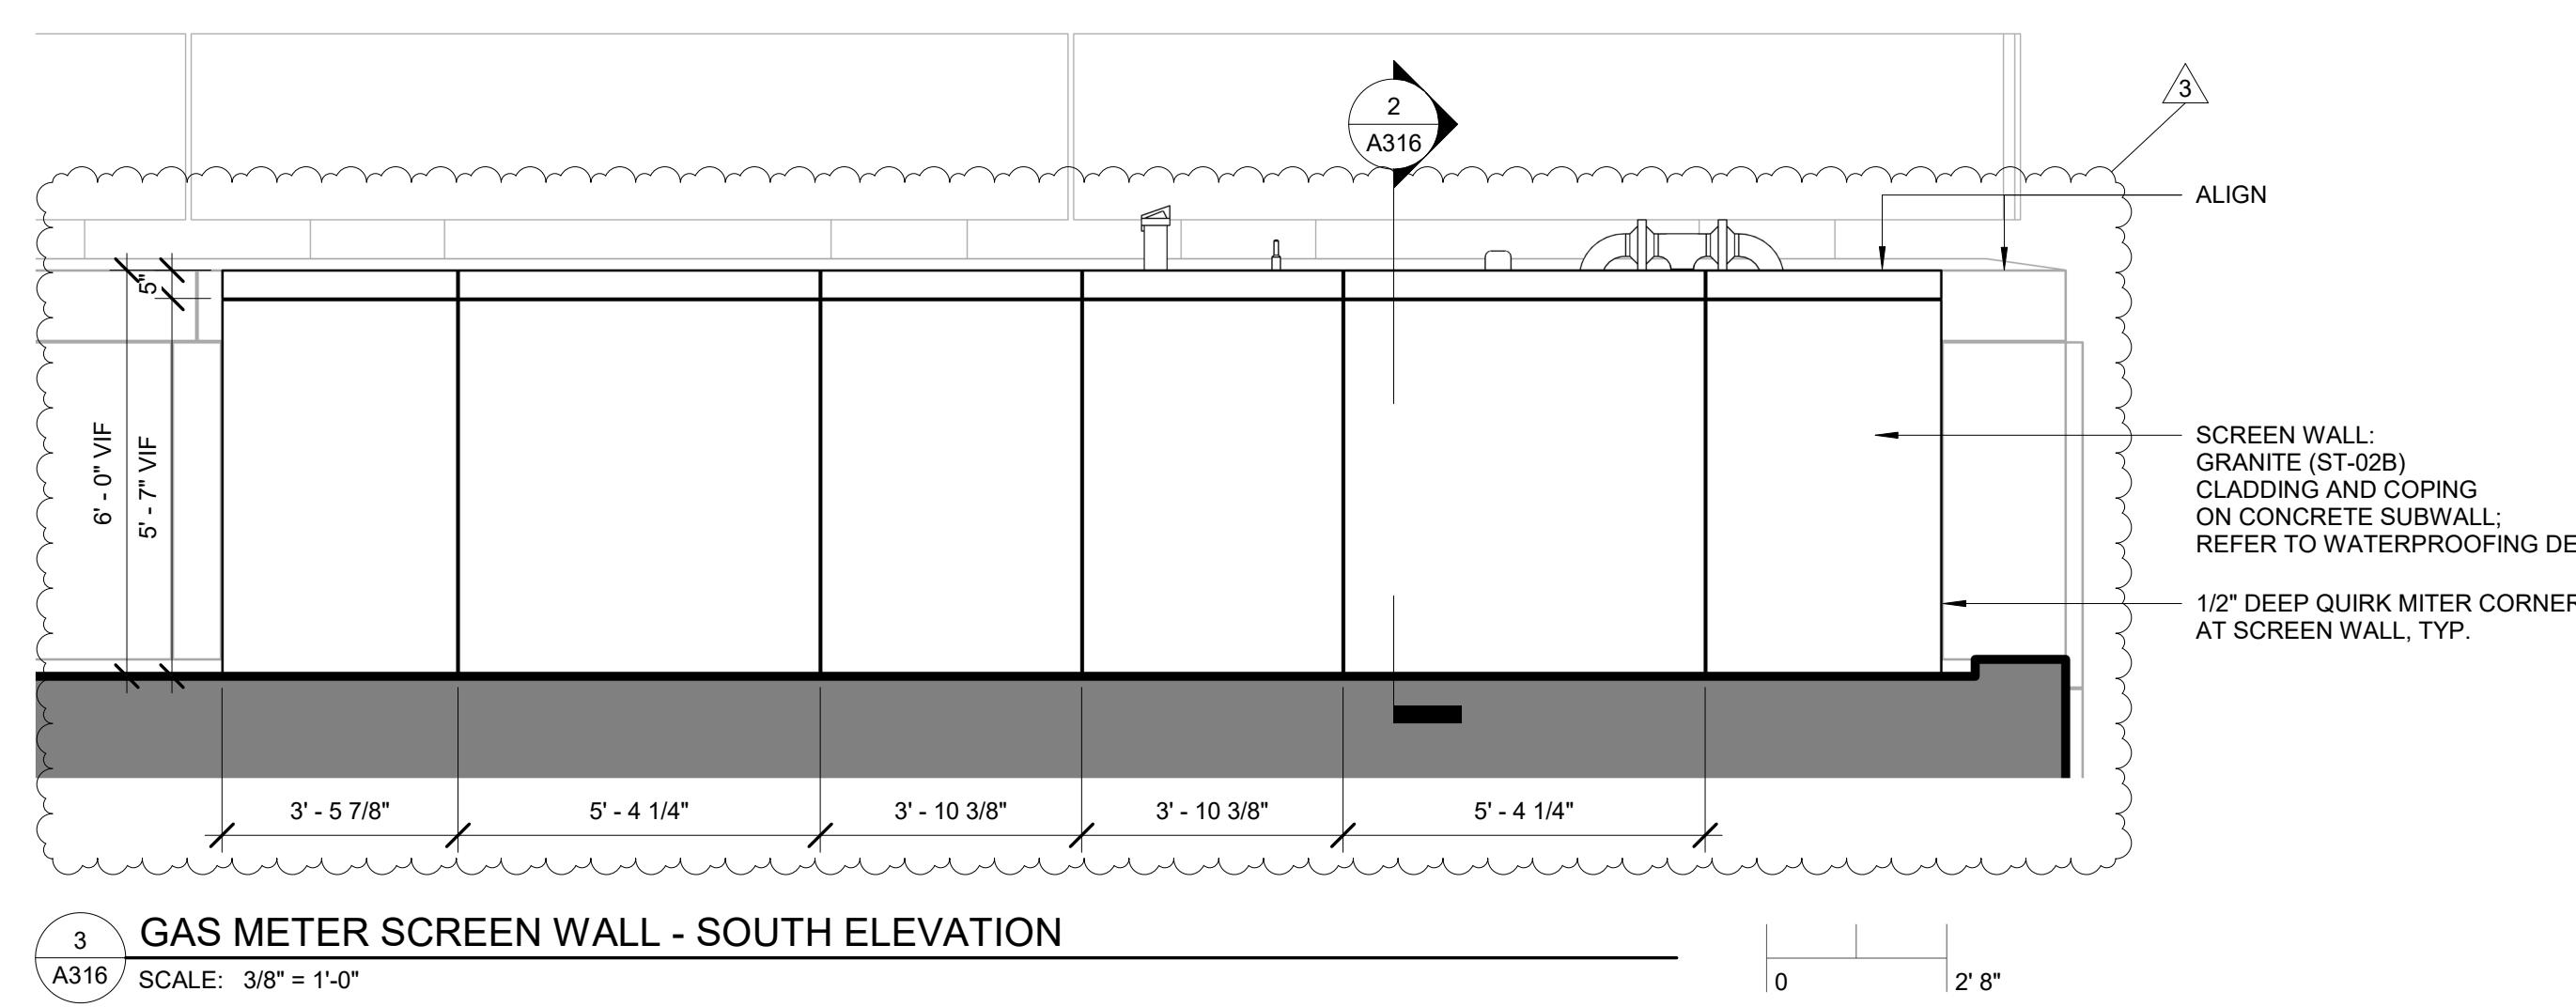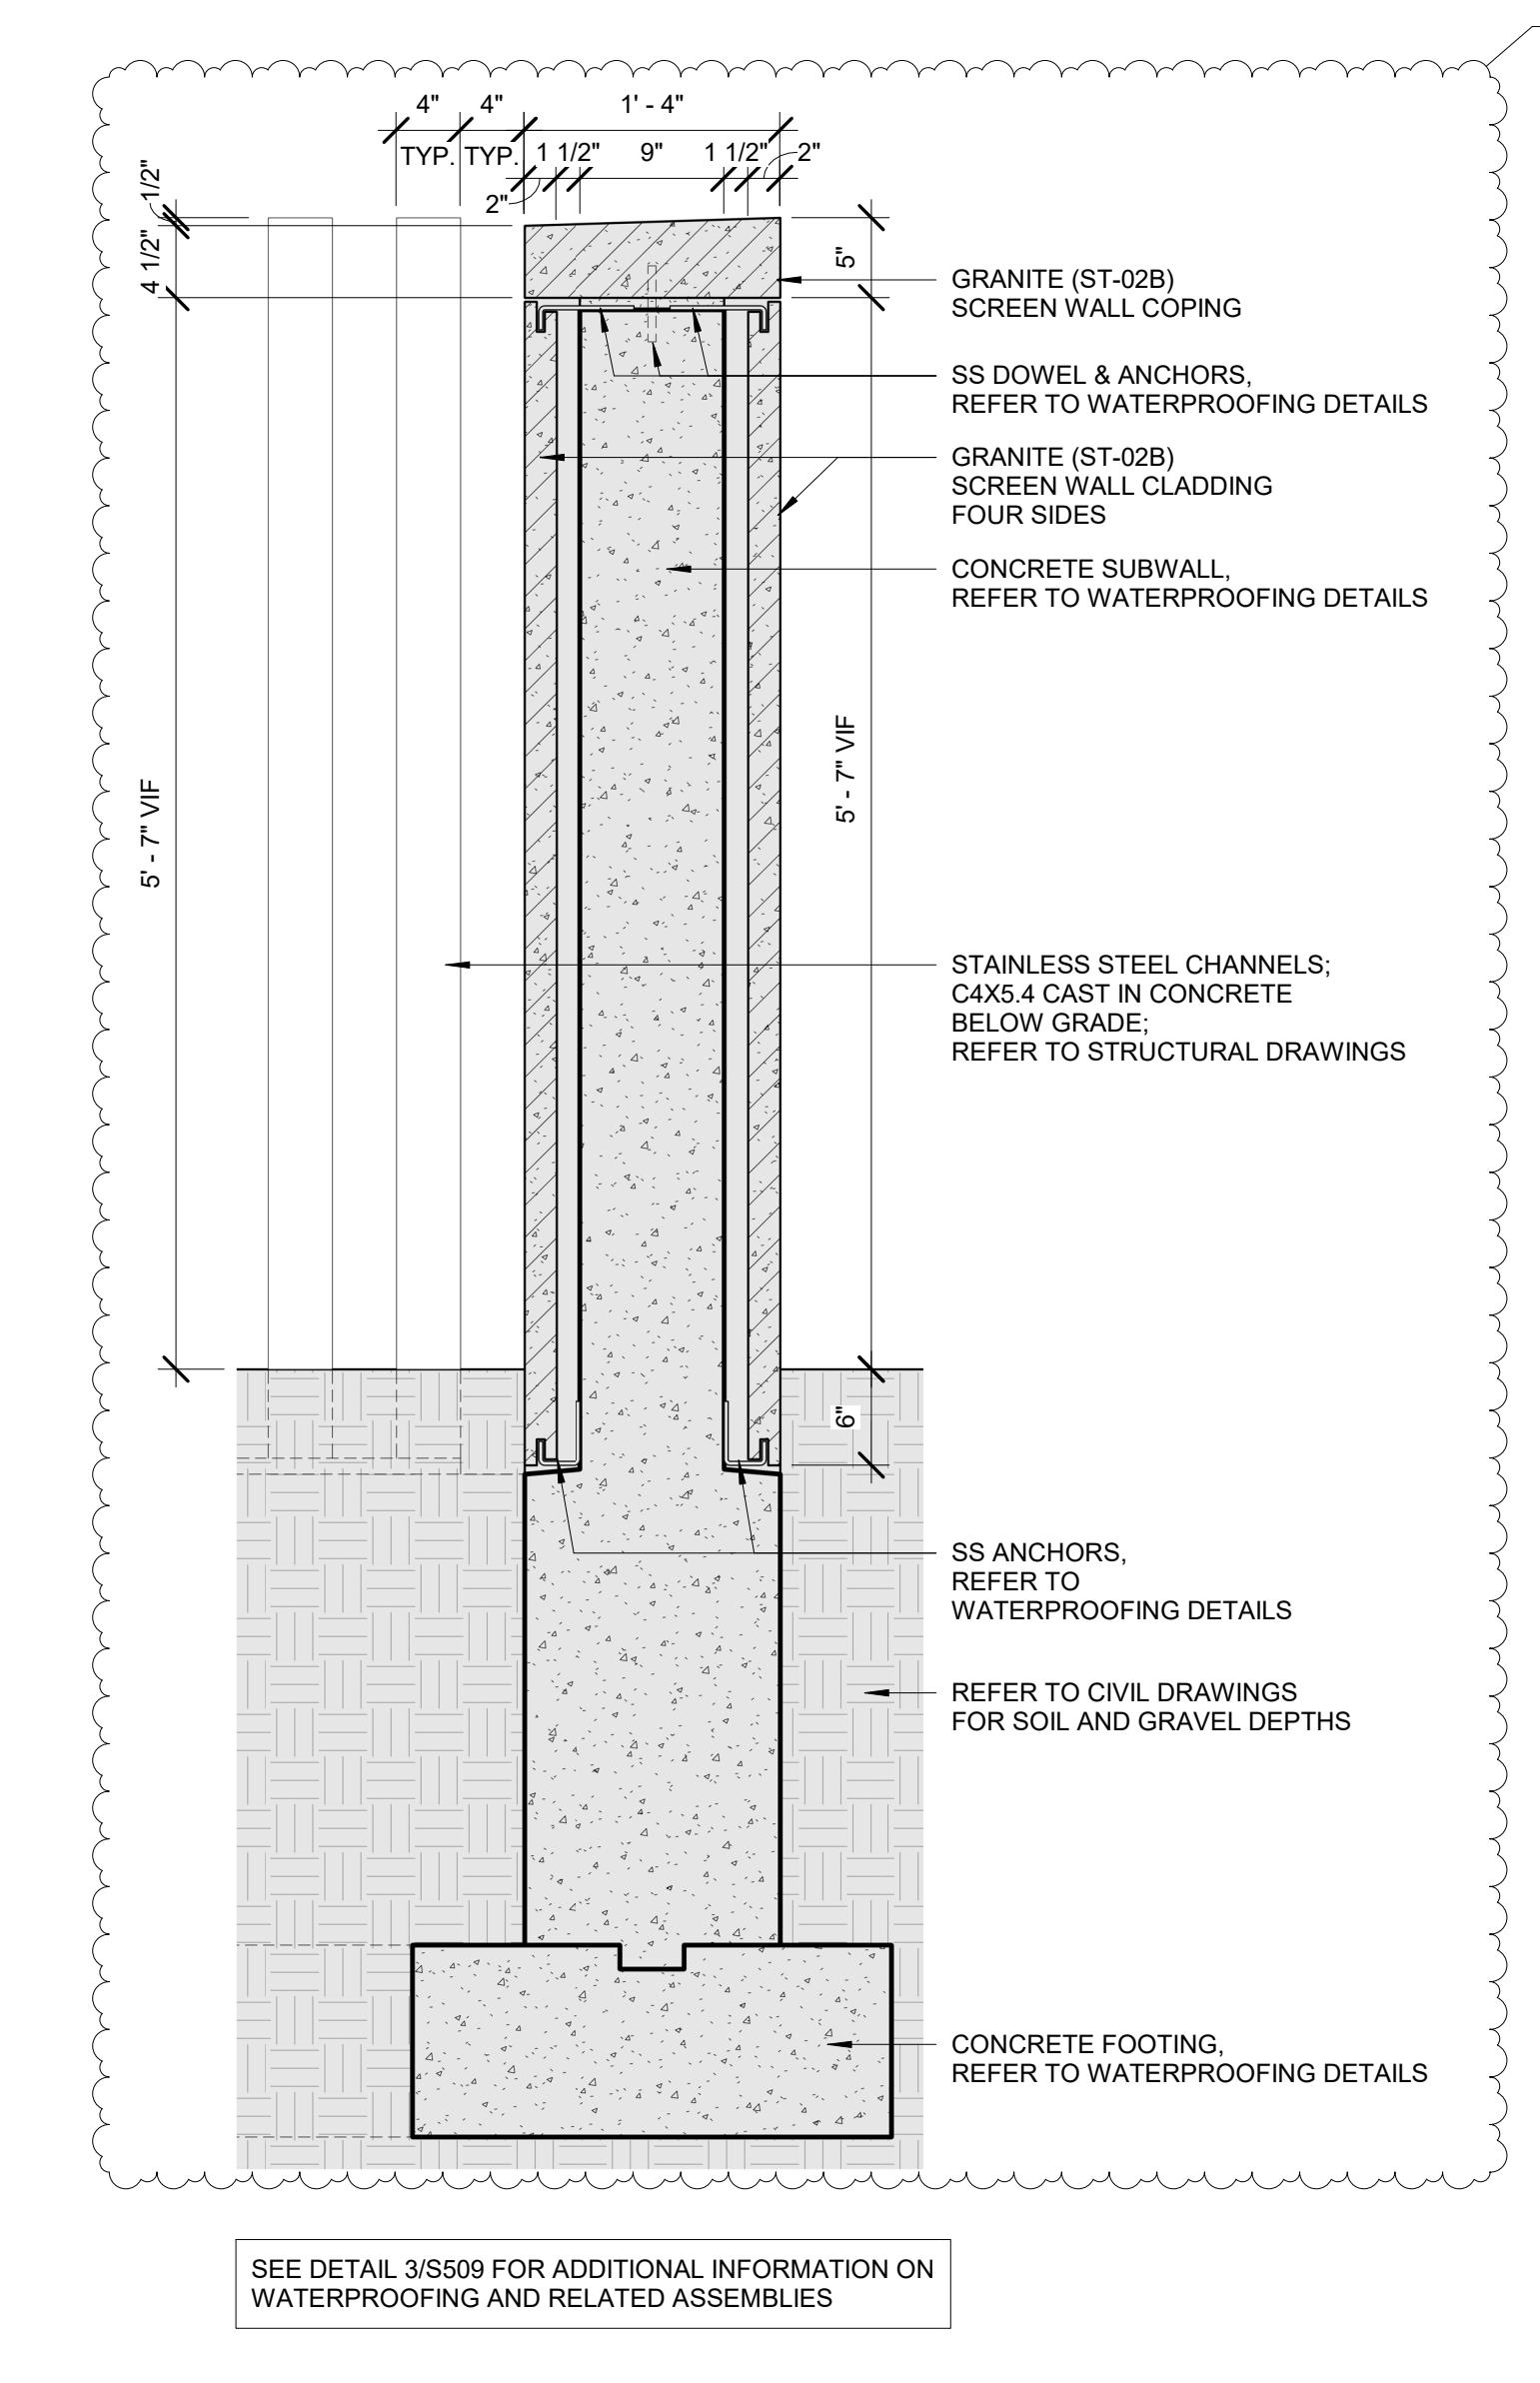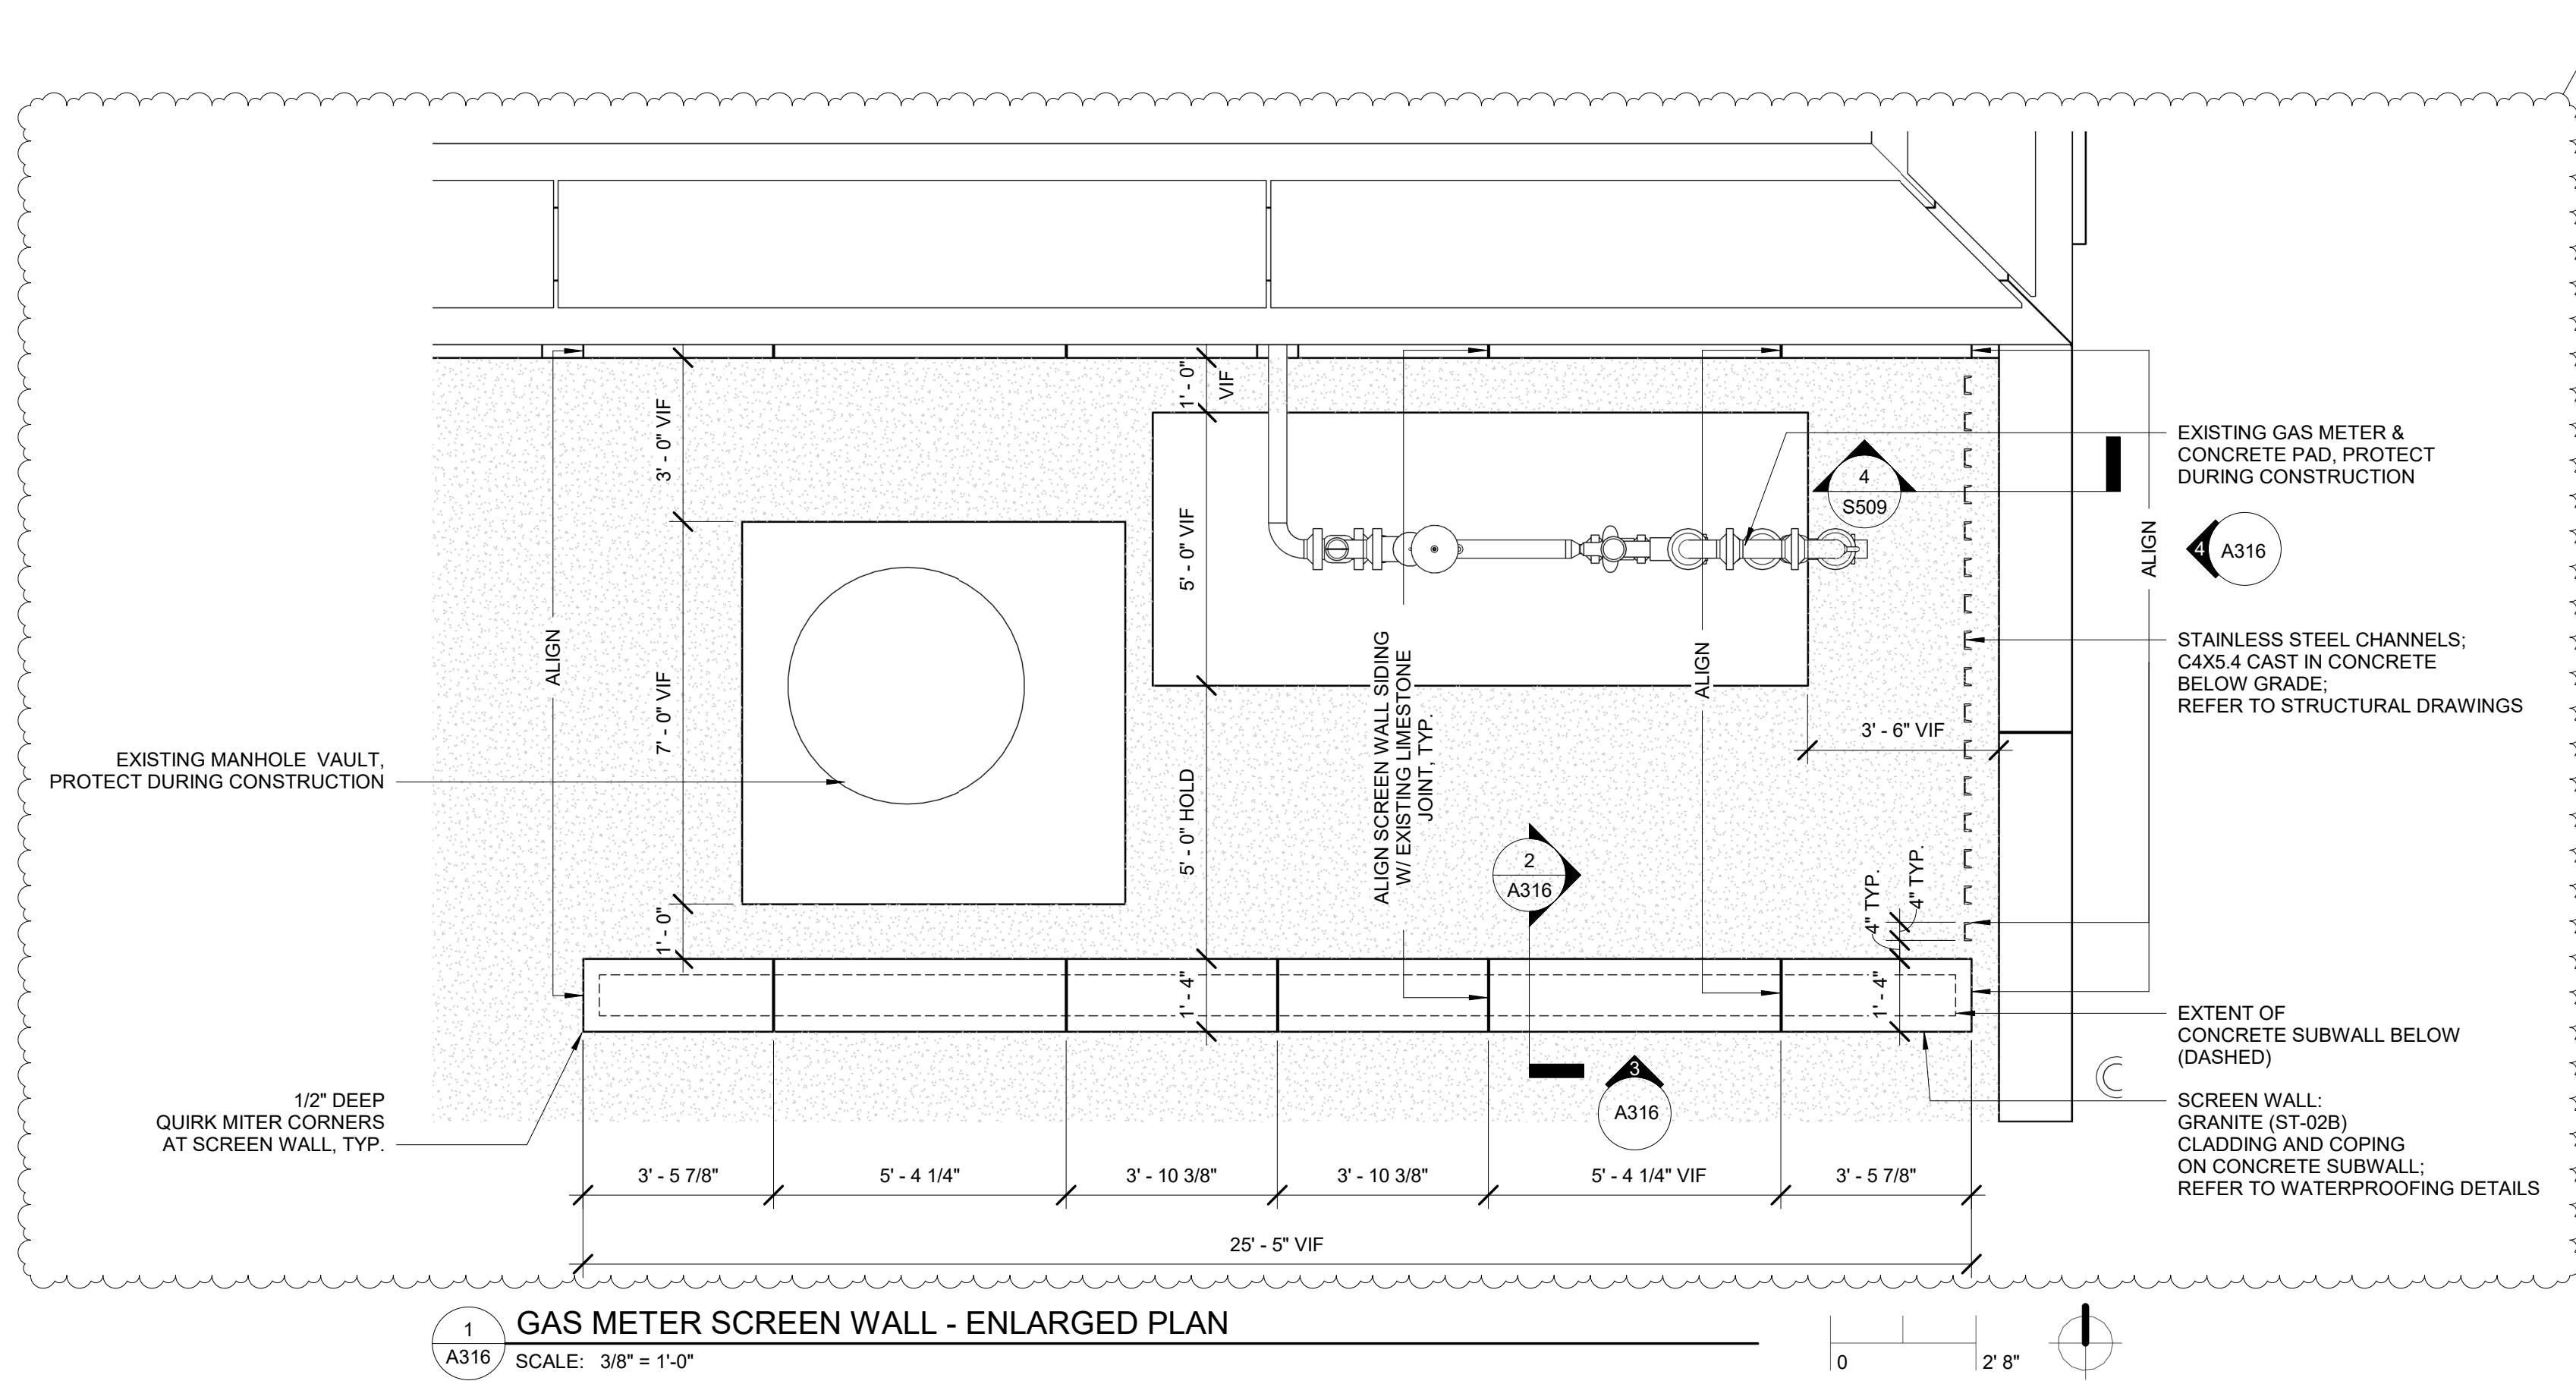

CDA

CHRIS DAWSON ARCHITECT

**COMMONWEALTH OF PENNSYLVANIA
DEPARTMENT OF GENERAL SERVICES**


PROJECT No. DGS 948-87 PHASE 1

PLAZA PAVER REPAIR / REPLACEMENT PA STATE MUSEUM, THE CAPITOL COMPLEX HARRISBURG, DAUPHIN COUNTY, PA


GAS METER SCREEN WALL - DETAIL DRAWINGS		
BY / JB	DATE 07.29.25	DRAWING NO. A316 3
ED BY	SCALE PER DWG	

DRAWING SET IS INTENDED FOR COLOR PRINTING

VERIFY SCALE	PLAZA PAVER REPAIR / REPLACEMENT PA STATE MUSEUM, THE CAPITOL COMPLEX HARRISBURG, DAUPHIN COUNTY, PA		
BAR IS ONE (1) INCH LONG ON ORIGINAL DRAWING: 0  1	IF BAR IS NOT ONE (1) INCH LONG, ADJUST SCALE ACCORDINGLY		
CONTRACTOR SHALL FIELD VERIFY ALL DIMENSIONS. VARIANCE FROM CONTRACT DOCUMENTS NOT PERMITTED WITHOUT PROFESSIONAL & BUREAU OF CONSTRUCTION APPROVAL	DRAWN BY DS / JB	DATE 07.29.25	DRAWING NO 
	CHECKED BY WE	SCALE PER DWG	

 

DRAWING SET IS INTENDED FOR COLOR PRINTING

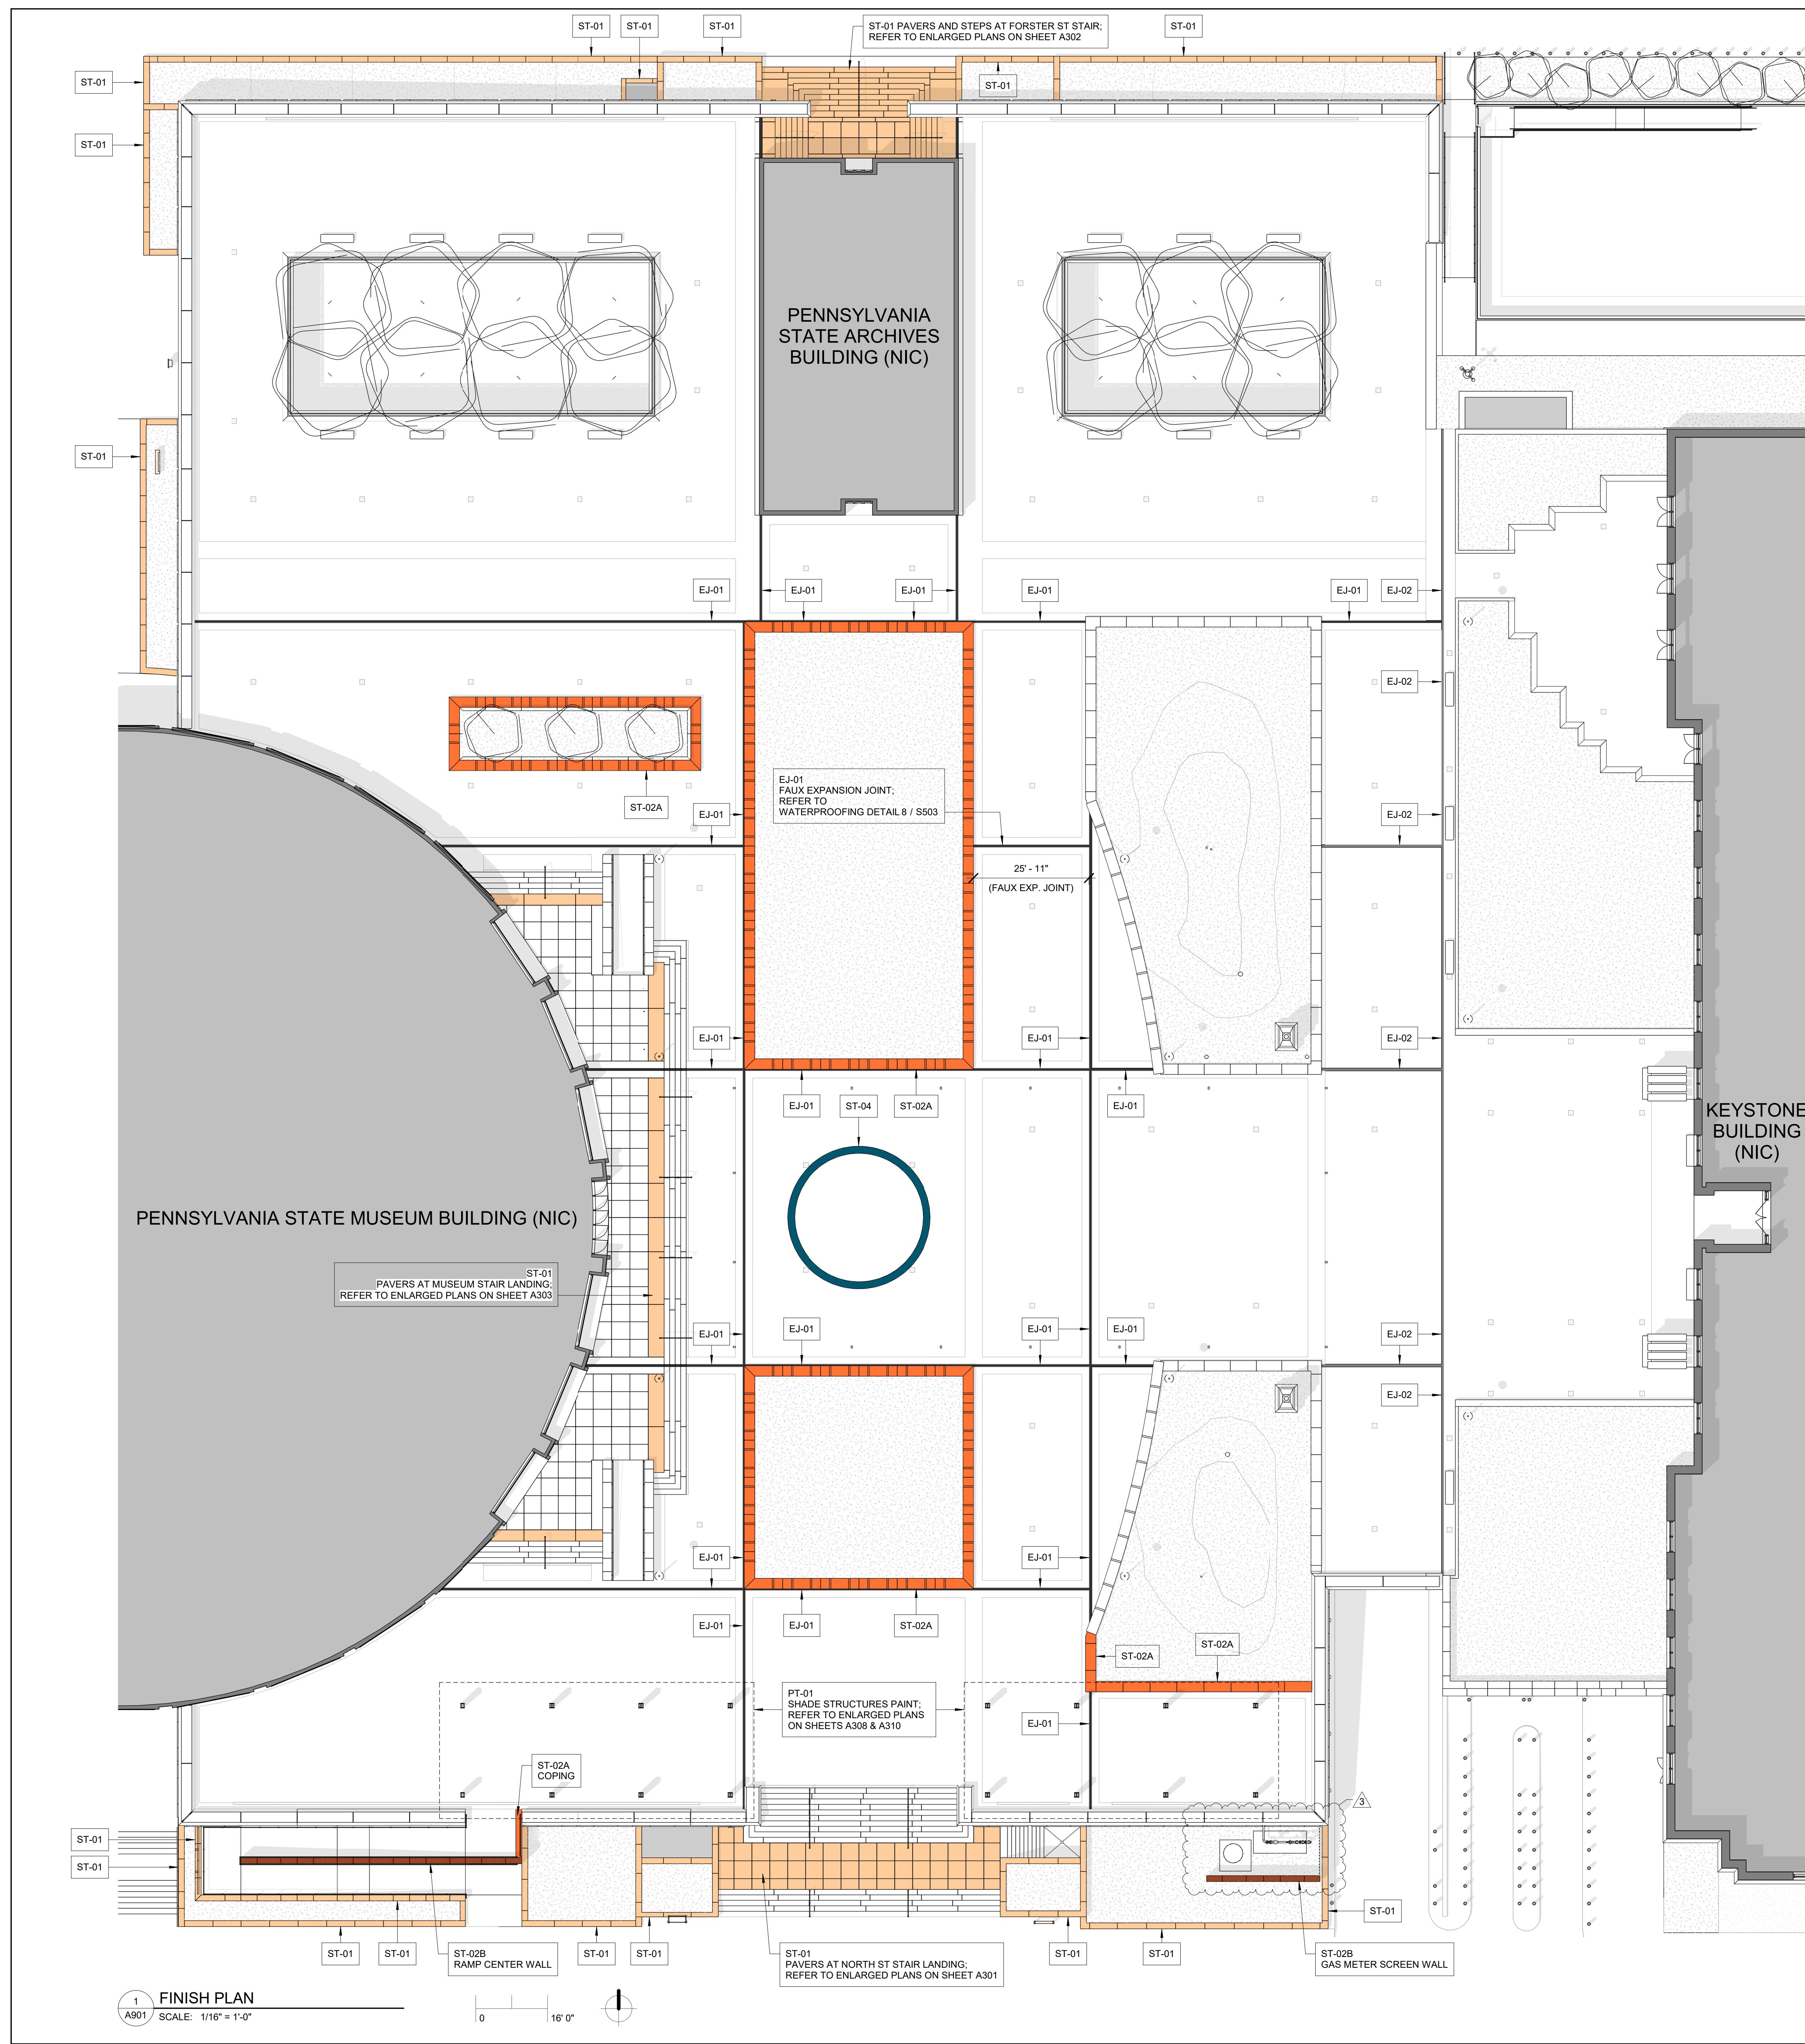

FINISH SCHEDULE		
TAG	PRODUCT	NOTES
EJ-01	EXPANSION JOINT, BRONZE 954 COVER PLATE	REFER TO WATERPROOFING DRAWINGS AND SPECIFICATIONS FOR EXPANSION JOINT DETAILS. FINISH SCHEDULE TO BE REFERENCE FOR COVER PLATE FINISH ONLY
EJ-02	EXPANSION JOINT, STAINLESS STEEL COVER PLATE	REFER TO WATERPROOFING DRAWINGS AND SPECIFICATIONS FOR EXPANSION JOINT DETAILS. FINISH SCHEDULE TO BE REFERENCE FOR COVER PLATE FINISH ONLY
ST-01	POLYCOR GRANITE, SILVER CLOUD, ANTIQUE FINISH	
ST-02A	POLYCOR GRANITE, WOODBURY GRAY, SANDBLASTED FINISH	
ST-02B	POLYCOR GRANITE, WOODBURY GRAY, ANTIQUE FINISH	
ST-03	SILVER SHADOW LIMESTONE, MACHINE SMOOTH FINISH	REFER TO ENLARGED PLANS FOR LOCATIONS
ST-04	BLACK GRANITE, FLAMED FINISH	CENTER PAVER RING, REFER TO ENLARGED PAVING PLANS, MATCH ARCHITECT'S CONTROL SAMPLE

FINISH KEY

	EJ-01
	EJ-02
	ST-01
	ST-02A
	ST-02B
	ST-04
	ST-03 (NOT SHOWN, REFER TO ENLARGED PLANS FOR LOCATIONS)

NOTES:

1. REFER TO SHEET A113 FOR LOCATIONS OF HARVESTED AND REUSED STONE
2. REFER TO SHEETS A104, A105, & A106 FOR PAVER FINISHES

3	Addenda 6	10/14/2025
AS-BUILT REVISIONS		
<p>PROFESSIONAL'S SIGNATURE DATE 09/06/2024</p>		

CDA

CHRIS DAWSON ARCHITECT
300 NORTH 2ND STREET, SUITE 701, HARRISBURG, PA 17101

COMMONWEALTH OF PENNSYLVANIA
DEPARTMENT OF GENERAL SERVICES
HARRISBURG, PENNSYLVANIA

D.G.S. PROJECT No.

DGS 948-87 PHASE 1

PLAZA PAVER REPAIR / REPLACEMENT
PA STATE MUSEUM,
THE CAPITOL COMPLEX
HARRISBURG, DAUPHIN COUNTY, PA

FINISH PLAN & SCHEDULE

DRAWN BY
JB
DATE
07.29.25
CHECKED BY
WE
SCALE
PER DWG
A901

DRAWING SET IS INTENDED FOR COLOR PRINTING

VERIFY SCALE		
BAR IS ONE (1) INCH LONG ON ORIGINAL DRAWING:		
0		1
IF BAR IS NOT ONE (1) INCH LONG, ADJUST SCALE ACCORDINGLY		
CONTRACTOR SHALL FIELD VERIFY ALL DIMENSIONS. VARIOUS CONTRACT DOCUMENTS NOT PERMITTED WITHOUT PROFESSIONAL & BUREAU OF CONSTRUCTION APPROVAL		
DRAWN BY JB CHECKED BY WE SCALE PER DWG	DATE 07.29.25	DRAWING NO.

